


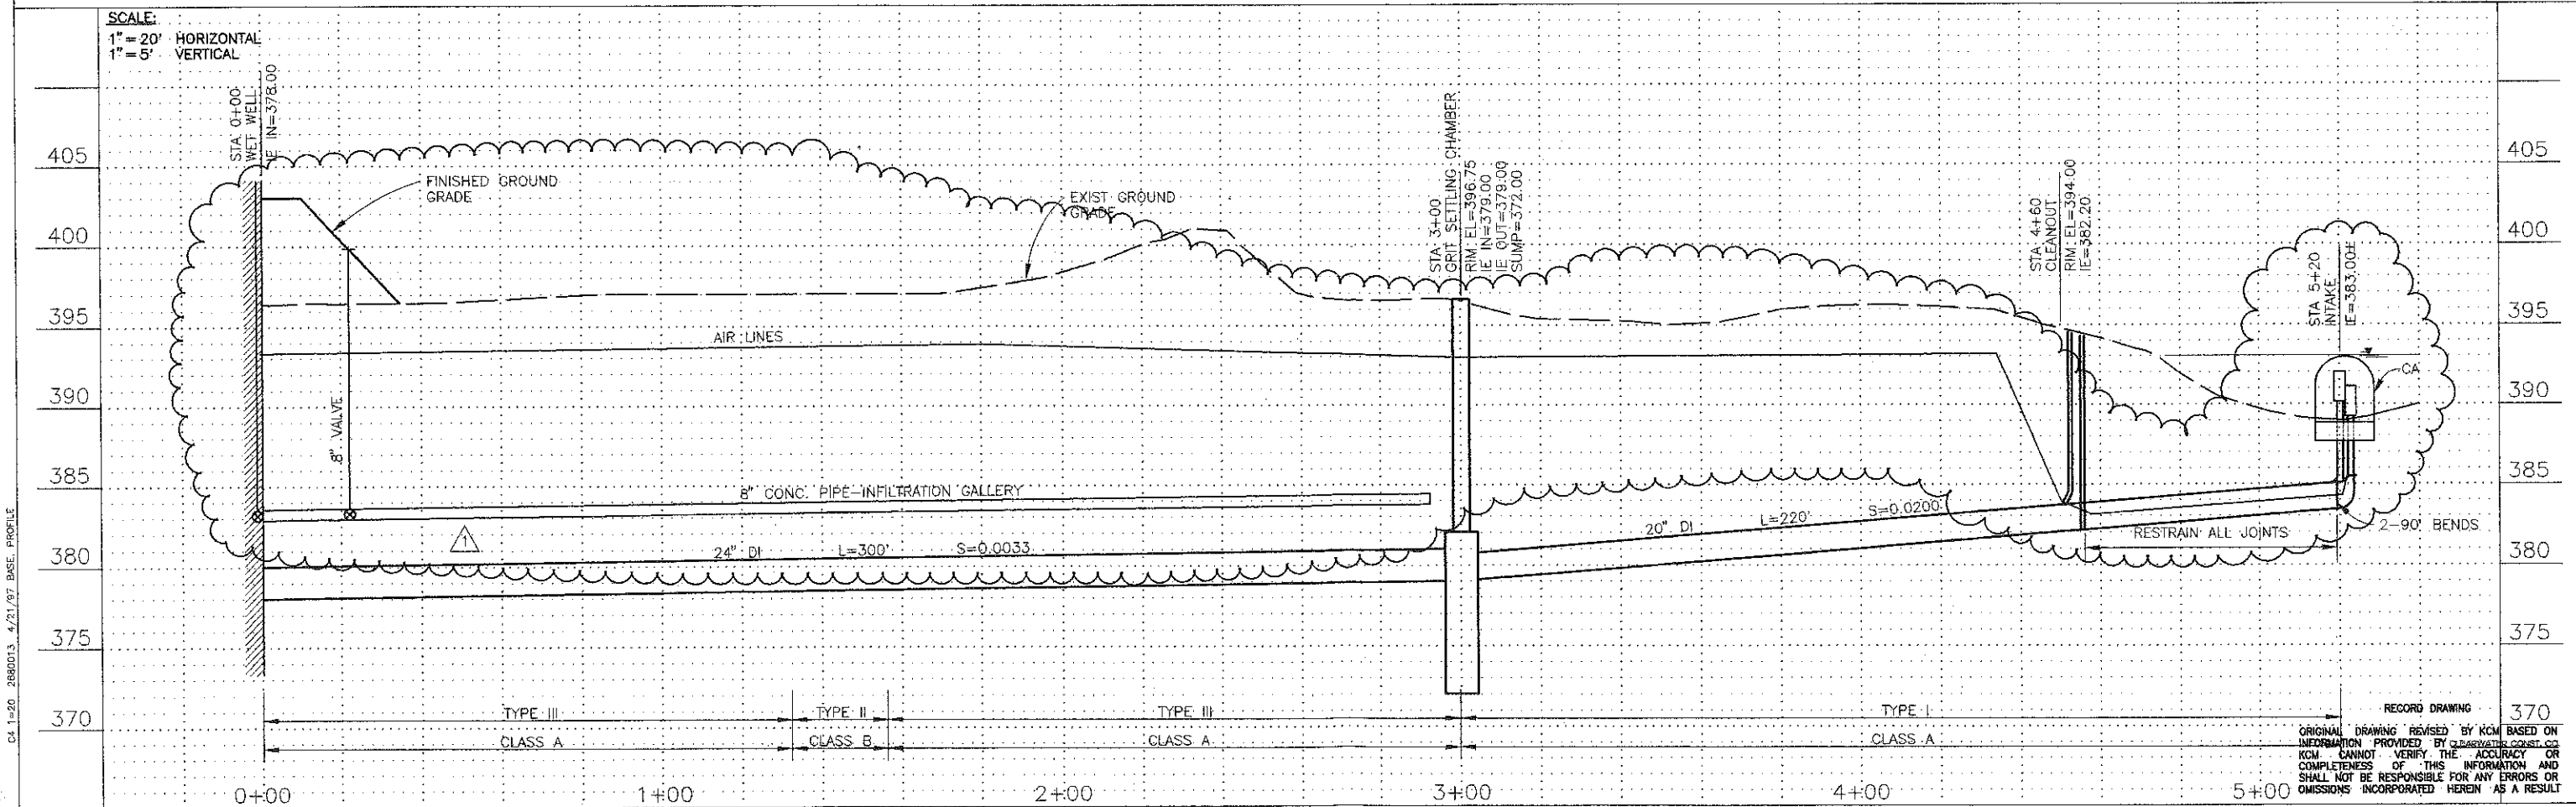


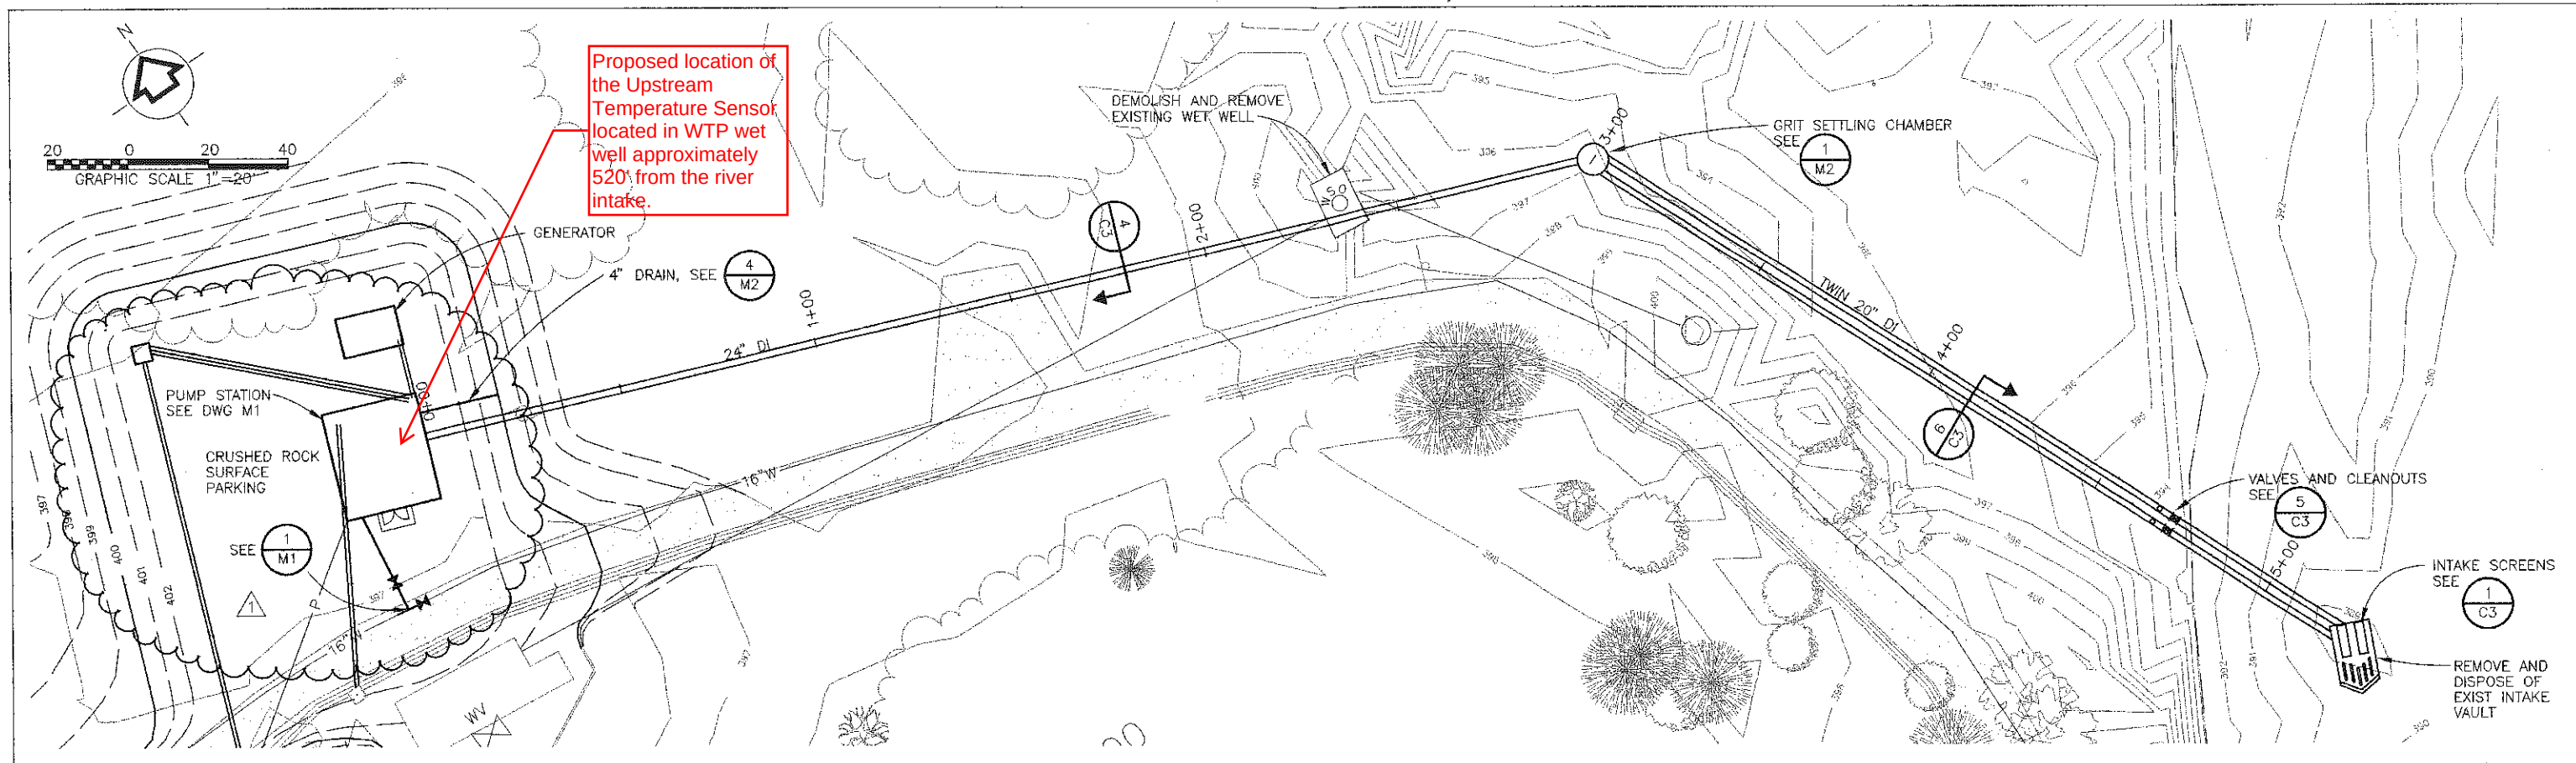


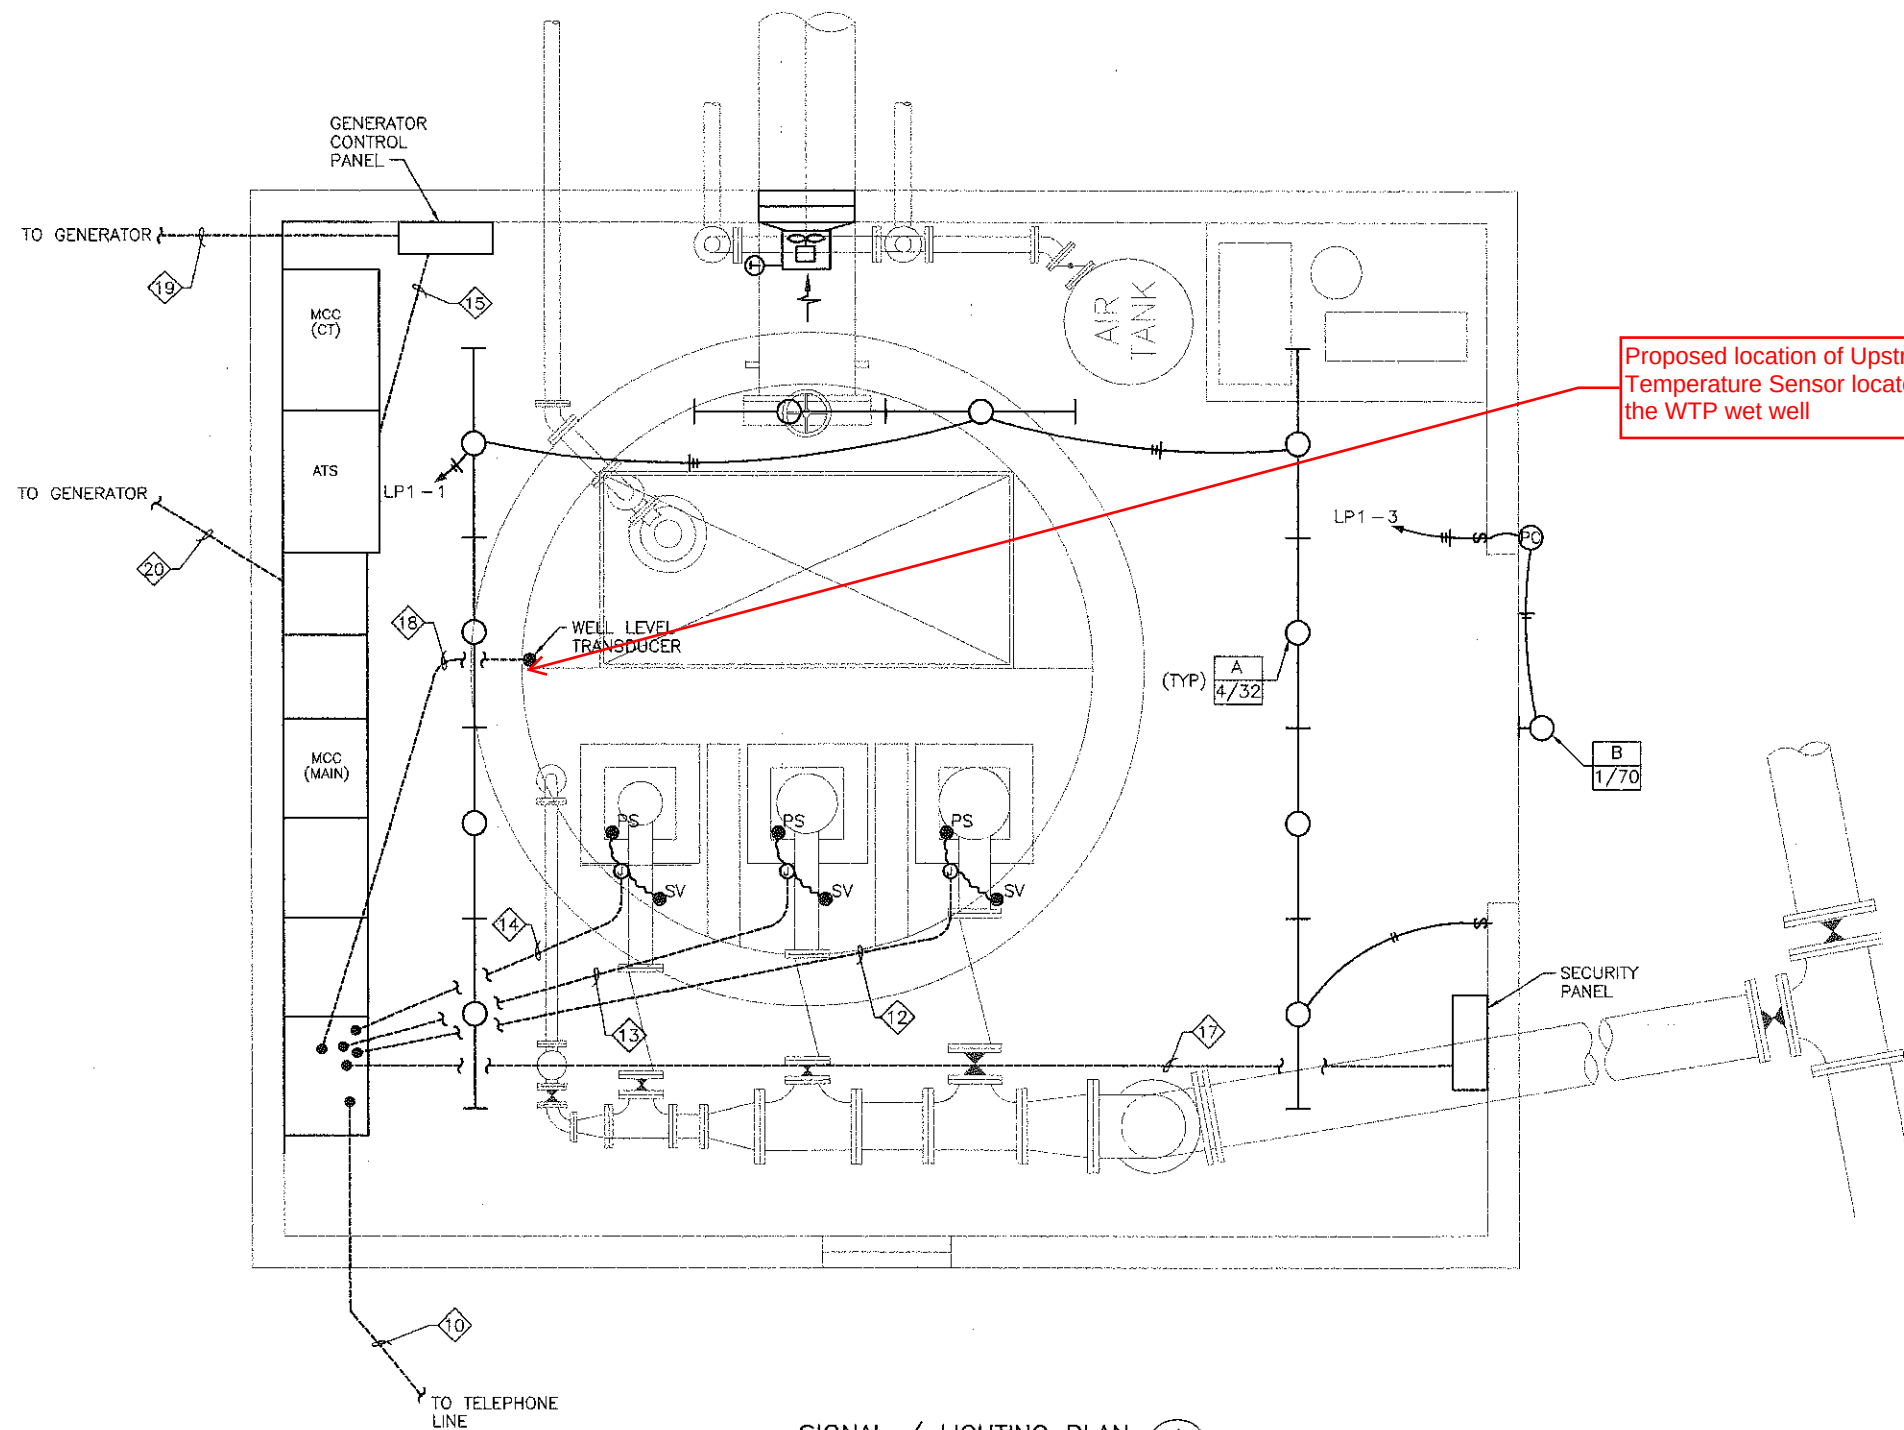

SIGNAL / LIGHTING PLAN 1
SCALE: 1/2" = 1'-0" E4

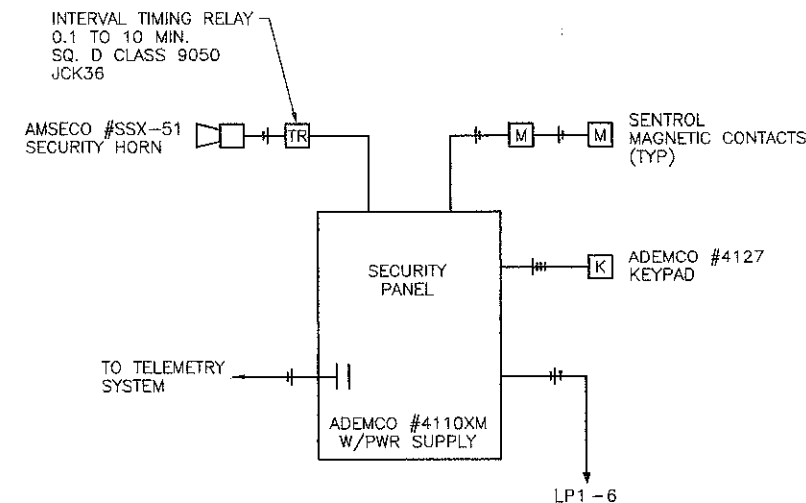

SECURITY CONTROL SYSTEM 2
SCALE: NTS E4

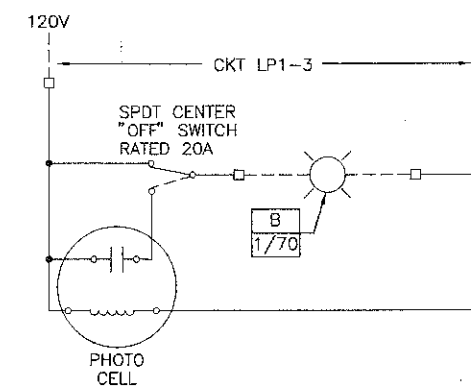

AREA LIGHTING CONTROL 3
SCALE: NTS E4

date	designed by	SES
	drawn by	MLB
scale	checked by	JSG
	approved by	JSG

RECORD DRAWING
ORIGINAL DRAWING REVISED BY
R&W ENGINEERING INC., BASED ON
INFORMATION PROVIDED BY
SCHNEIDER EQUIPMENT, INC.
R&W ENGINEERING, INC. CAN NOT
VERIFY THE ACCURACY OR COMPLETENESS
OF THIS INFORMATION AND SHALL NOT BE
RESPONSIBLE FOR ANY ERRORS OR OMISSIONS
INCORPORATED HEREIN AS A RESULT.


revisions	RECORD DWGS 10/29/97
KCM NO.	

City of Molalla, Oregon
INTAKE PUMP STATION


ELECTRICAL
SIGNAL/LIGHTING PLAN

drawing number	E4
sheet number	4 of 9

025.050.002.E004

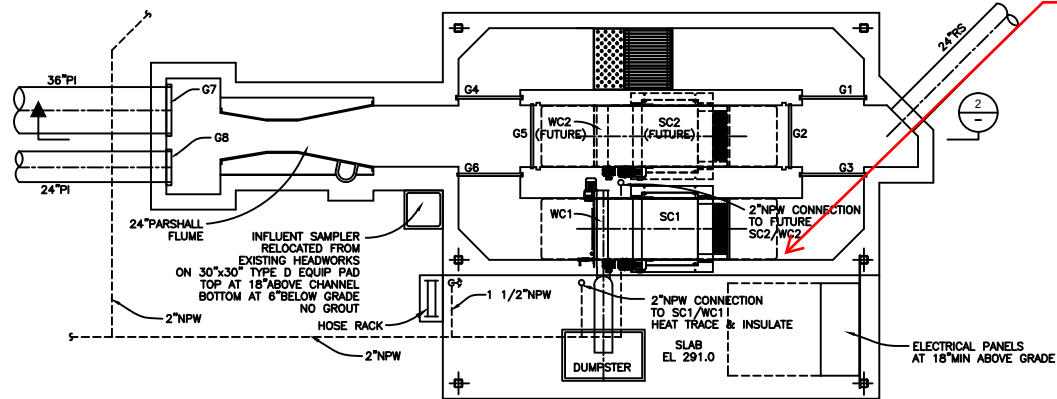


HEADWORKS
MECHANICAL PLAN
1/4"=1'-0"

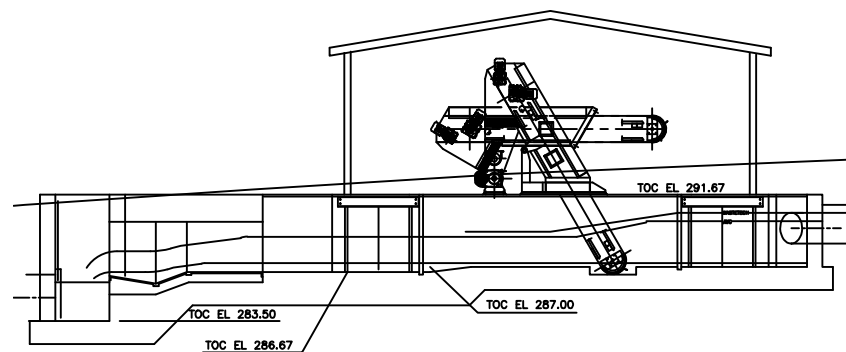


HEADWORKS
MECHANICAL SECTION
1/4"=1'-0"

Proposed Upstream pH Sensor
location. Located in the Inlet
Channel of the Headworks.

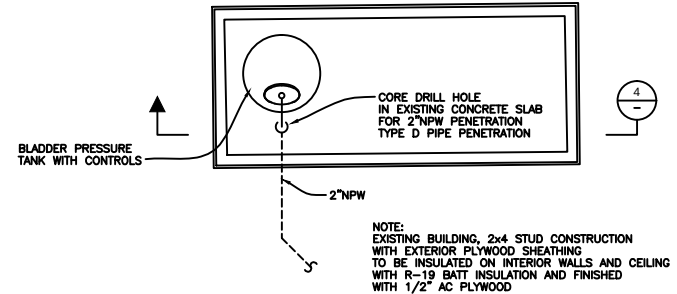

EXISTING HEADWORKS BUILDING
PLAN
1/4"=1'-0"

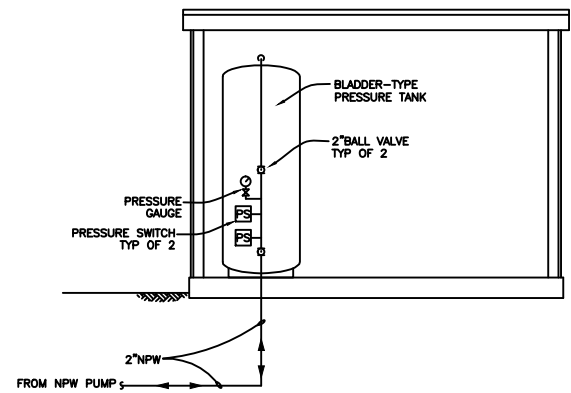

EXISTING HEADWORKS BUILDING
SECTION
1/2"=1'-0"

																																																																																																																																																																																																																																																																																																																																																																																																																																																																																																																																																																																																																																																																																																																																																																																																																																																																																																																																																																																																																																																																																																																																																																																																																																																																																																																																																																																																																						</
--	--	----

Tetra Tech/KCM, Inc.
7080 SW Fir Loop
Portland, Oregon 97223
503-684-9097 Fax: 503-598-0583



City of Molalla WASTEWATER TREATMENT PLANT IMPROVEMENTS HEADWORKS MECHANICAL PLAN AND SECTIONS	FILE NO: M101.dwg PROJECT NO: 2130053 DWG NO: M101 SHEET: 21 OF 66
--	---

This drawing is full size when 22"x 34" or is reduced to half size when 11"x17"

COPYRIGHT 2002, TETRA TECH/KCM, INC. ALL RIGHTS RESERVED

FLOW FROM
CASCADE
REAERATION
STRUCTURE

DRAIN SUMP
ASSEMBLY

VALVE BOX SET
IN VAULT TOP

BELOW GRADE
DRAIN VAULT

DISCHARGE TO
MOLALLA RIVER
OUTFALL

AIR-VAC.
VALVE


SUMP

SAMPLING
POINT

WASTE WATER
DISCHARGE

WASTE

WASTE WATER
DISCHARGE

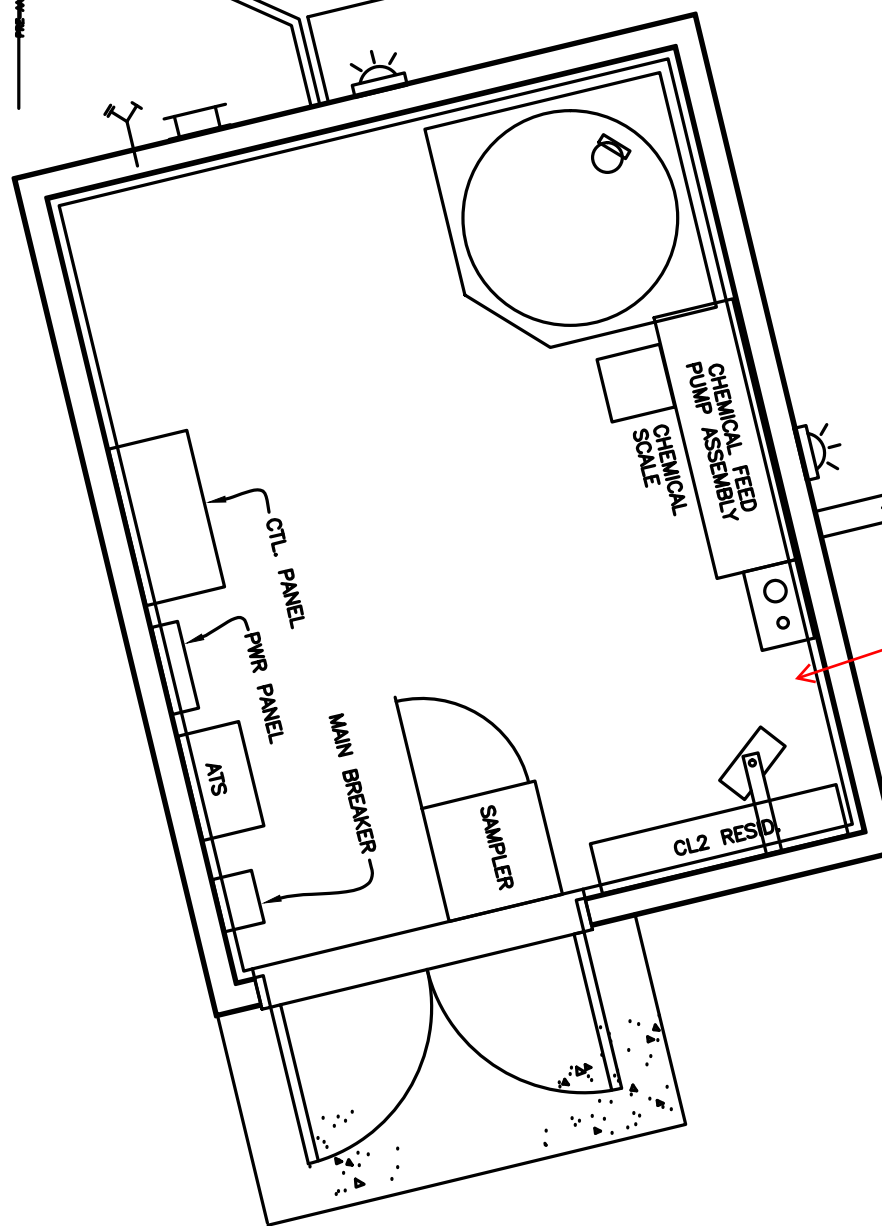

Proposed location of Downstream pH
Sensor to be located within Discharge
Monitoring Building. Water sample will
be from existing waste water discharge
sample line.