


CROSS SECTION A-A
 Hor. Scale: 1" = 50'
 Vert. Scale: 1" = 50'


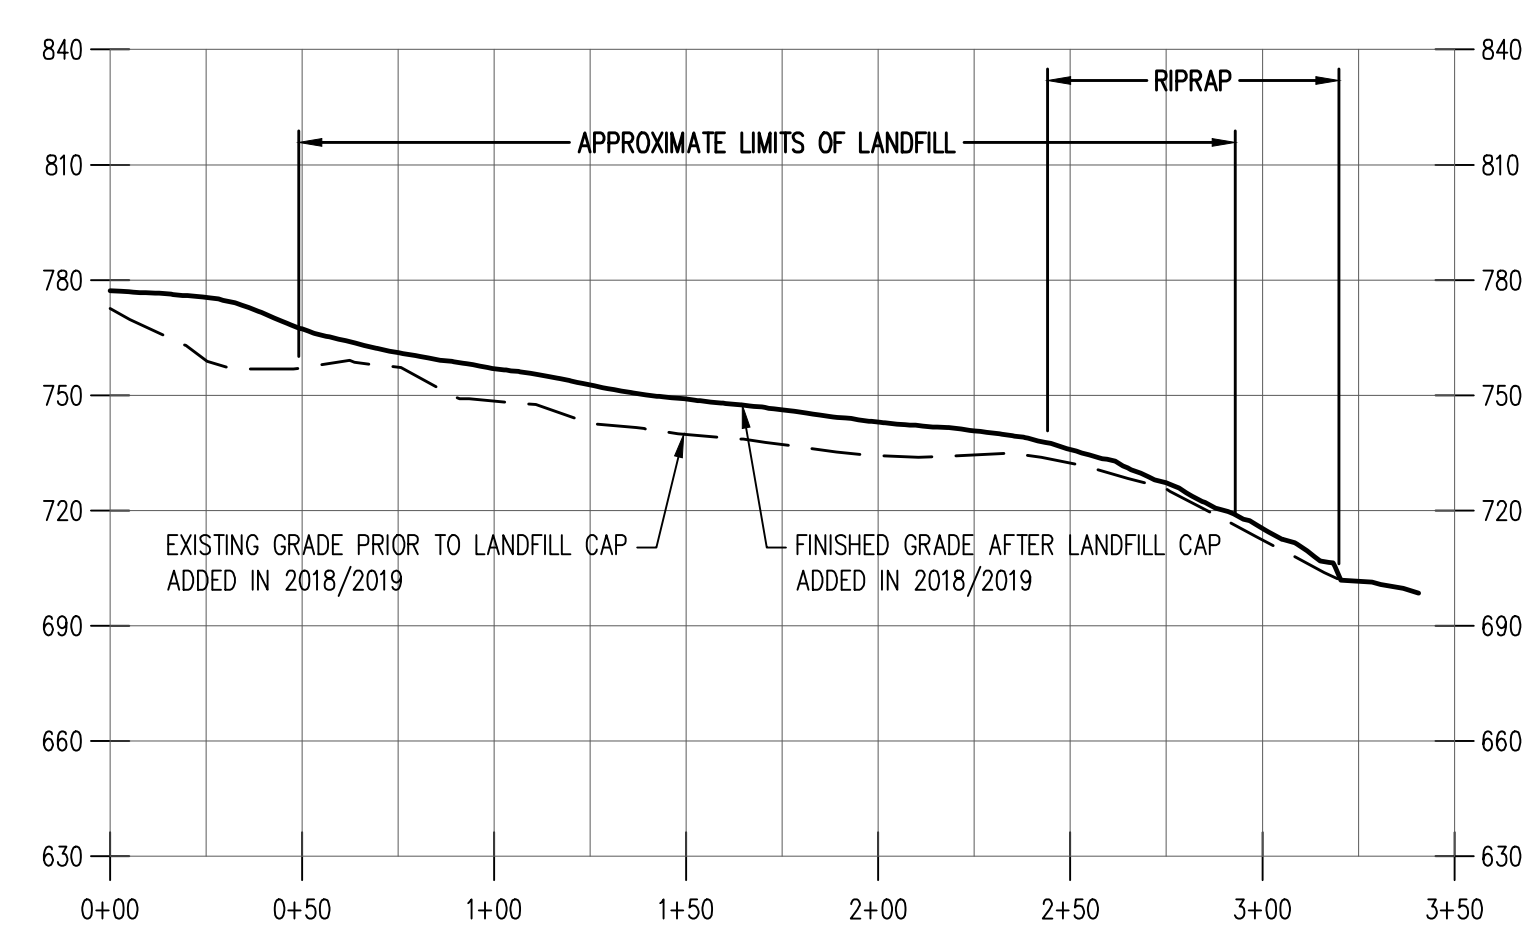


CROSS SECTION B-B
 Hor. Scale: 1" = 50'
 Vert. Scale: 1" = 50'

CONSTRUCTION KEYED NOTES:

- 1 SUBDRAIN
- 2 KEYWAY SUBDRAIN

NOTE:
 A CAP CONSISTING OF THREE (3) FEET OF CLEAN SOIL AND/OR A MINIMUM OF ONE (1) FOOT OF LARGE DIAMETER (0.5 FEET OR GREATER DIAMETER) COBBLES AND BOULDER FILL WAS SELECTED AS THE MANAGED SOIL CAP REMEDIAL ACTION.

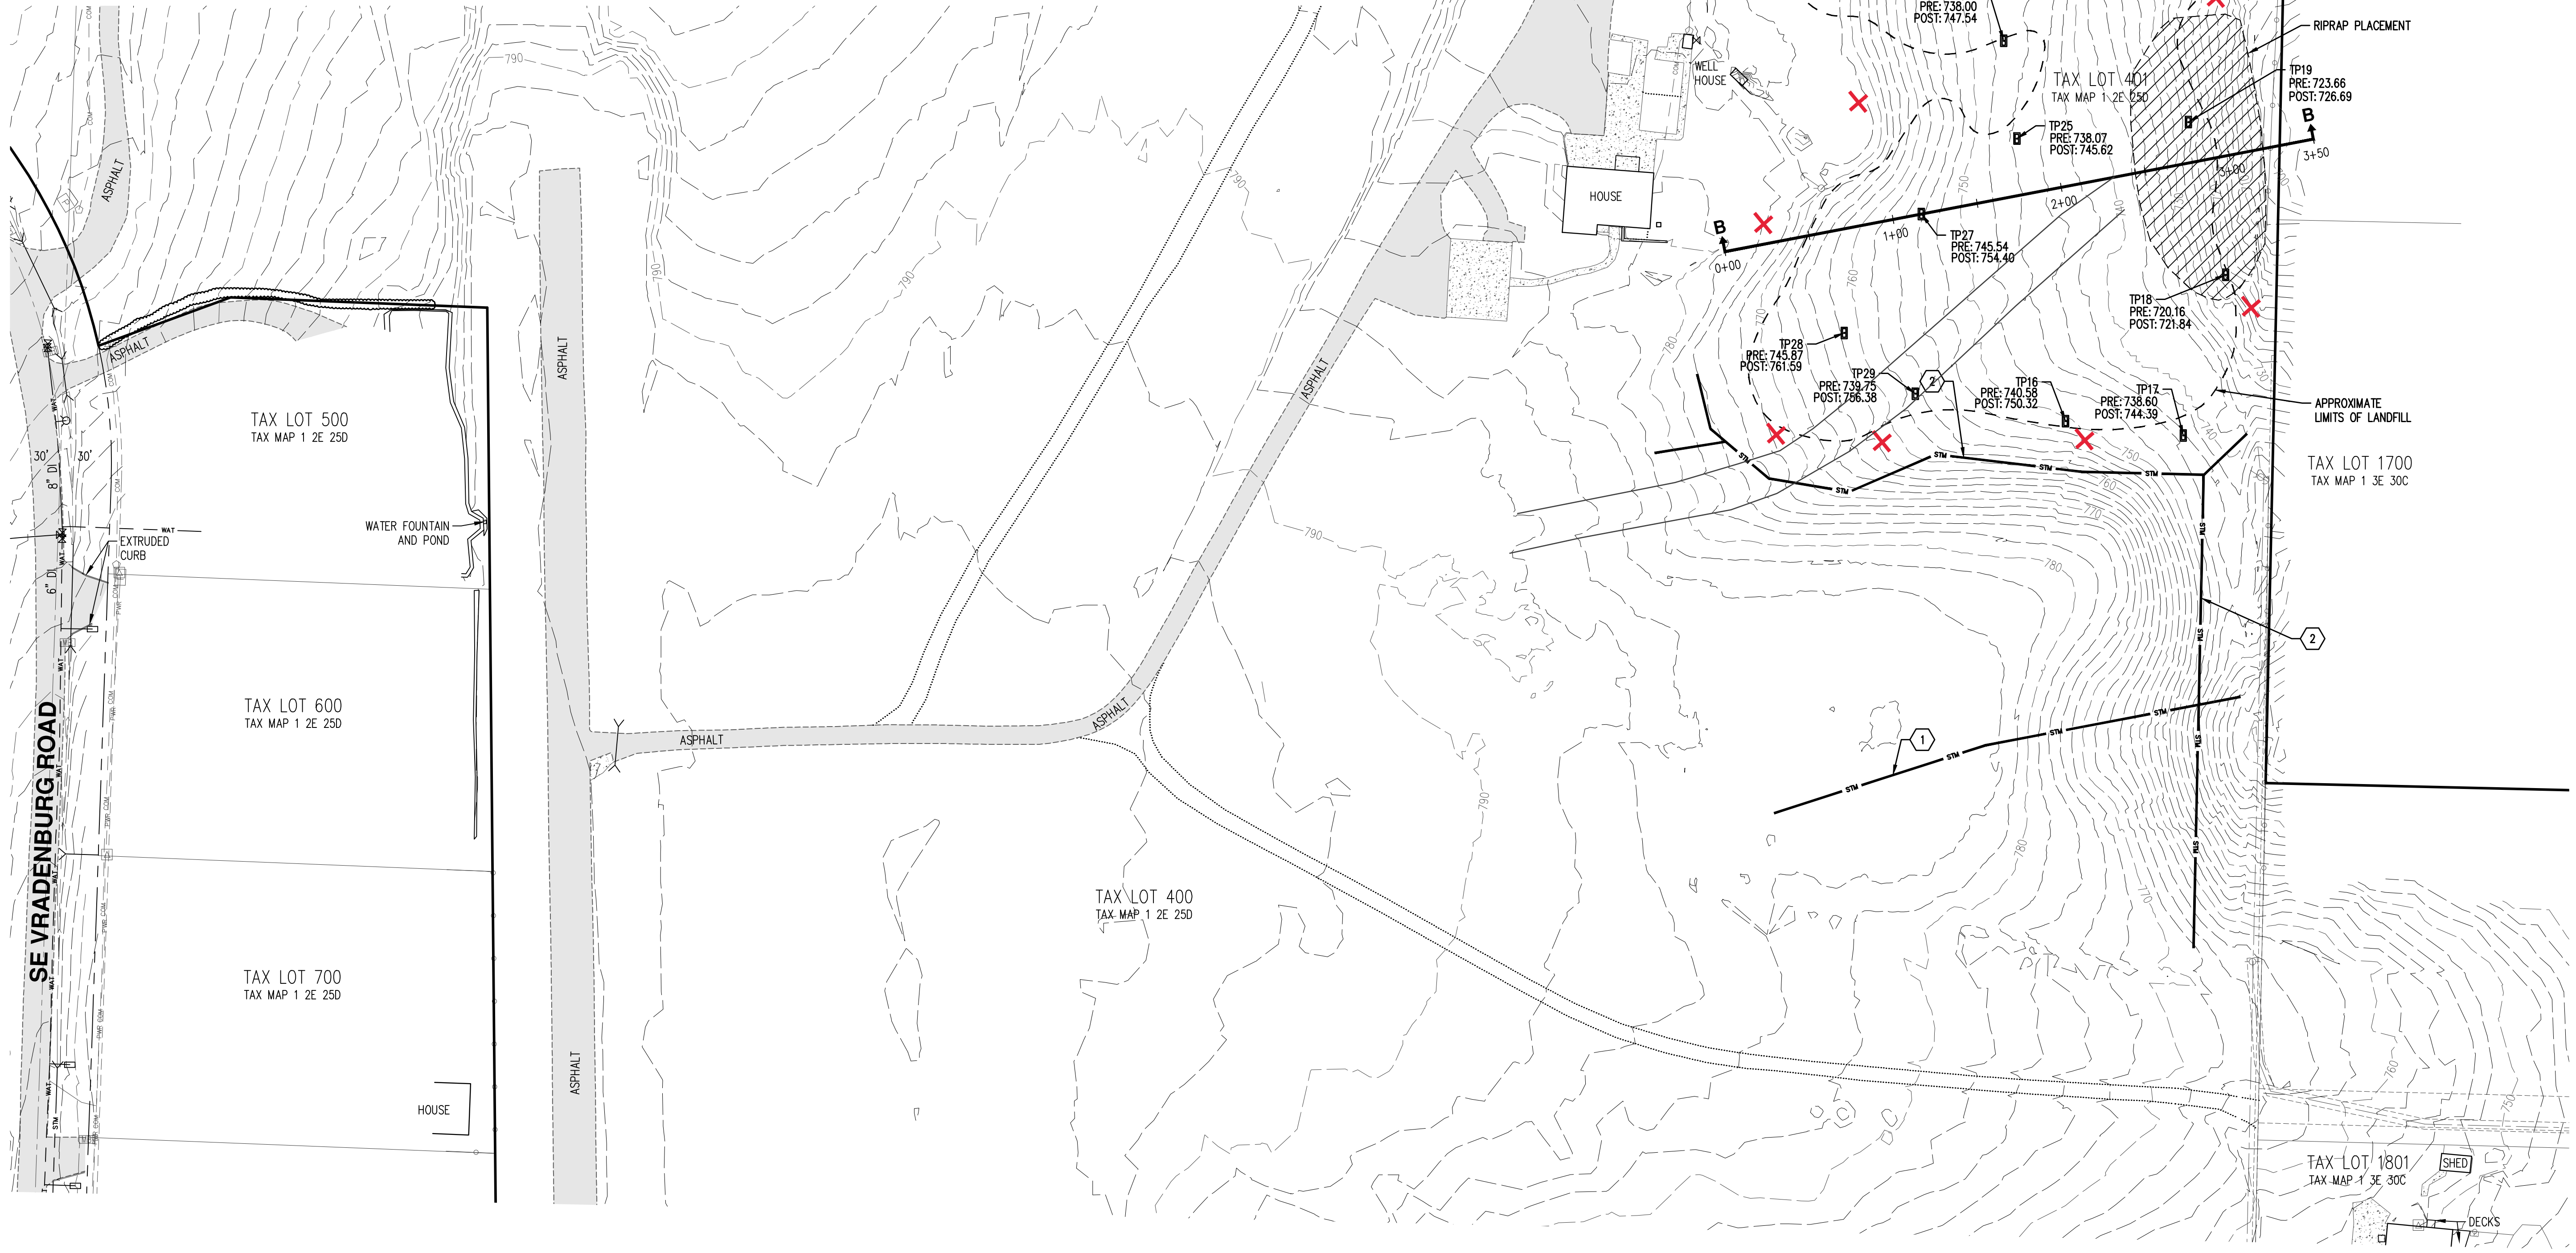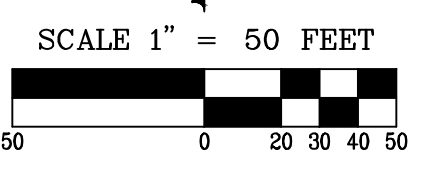


AKS
 AKS ENGINEERING & FORESTRY, LLC
 12965 SW HERMAN RD. STE 100
 TUALATIN, OR 97062
 P: 503.563.6151
 F: 503.563.6152
 aks-eng.com

10010 SE VRADENBURG ROAD
 ENG-01-17 PUD-02-15
HAPPY VALLEY OREGON
 CLACKAMAS COUNTY TAX MAPS 1 2E 25D
 TAX LOTS 400 & 401

TROH LANDFILL
SOIL CAP AS-BUILT

DESIGNED BY: JRN
 DRAWN BY: JRN
 CHECKED BY: MBH
 SCALE: AS NOTED
 DATE: 03/13/2020

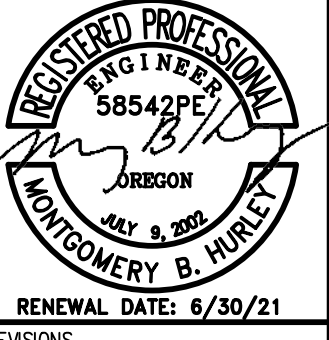

REVISIONS

JOB NUMBER
3415

SHEET
EXA

AKS DRAWING FILE: 3415 20200313 SOIL CAP AS-BUILDING | LAYOUT: EXHIBIT