


1"=200'

This map was prepared for
assessment purpose only.

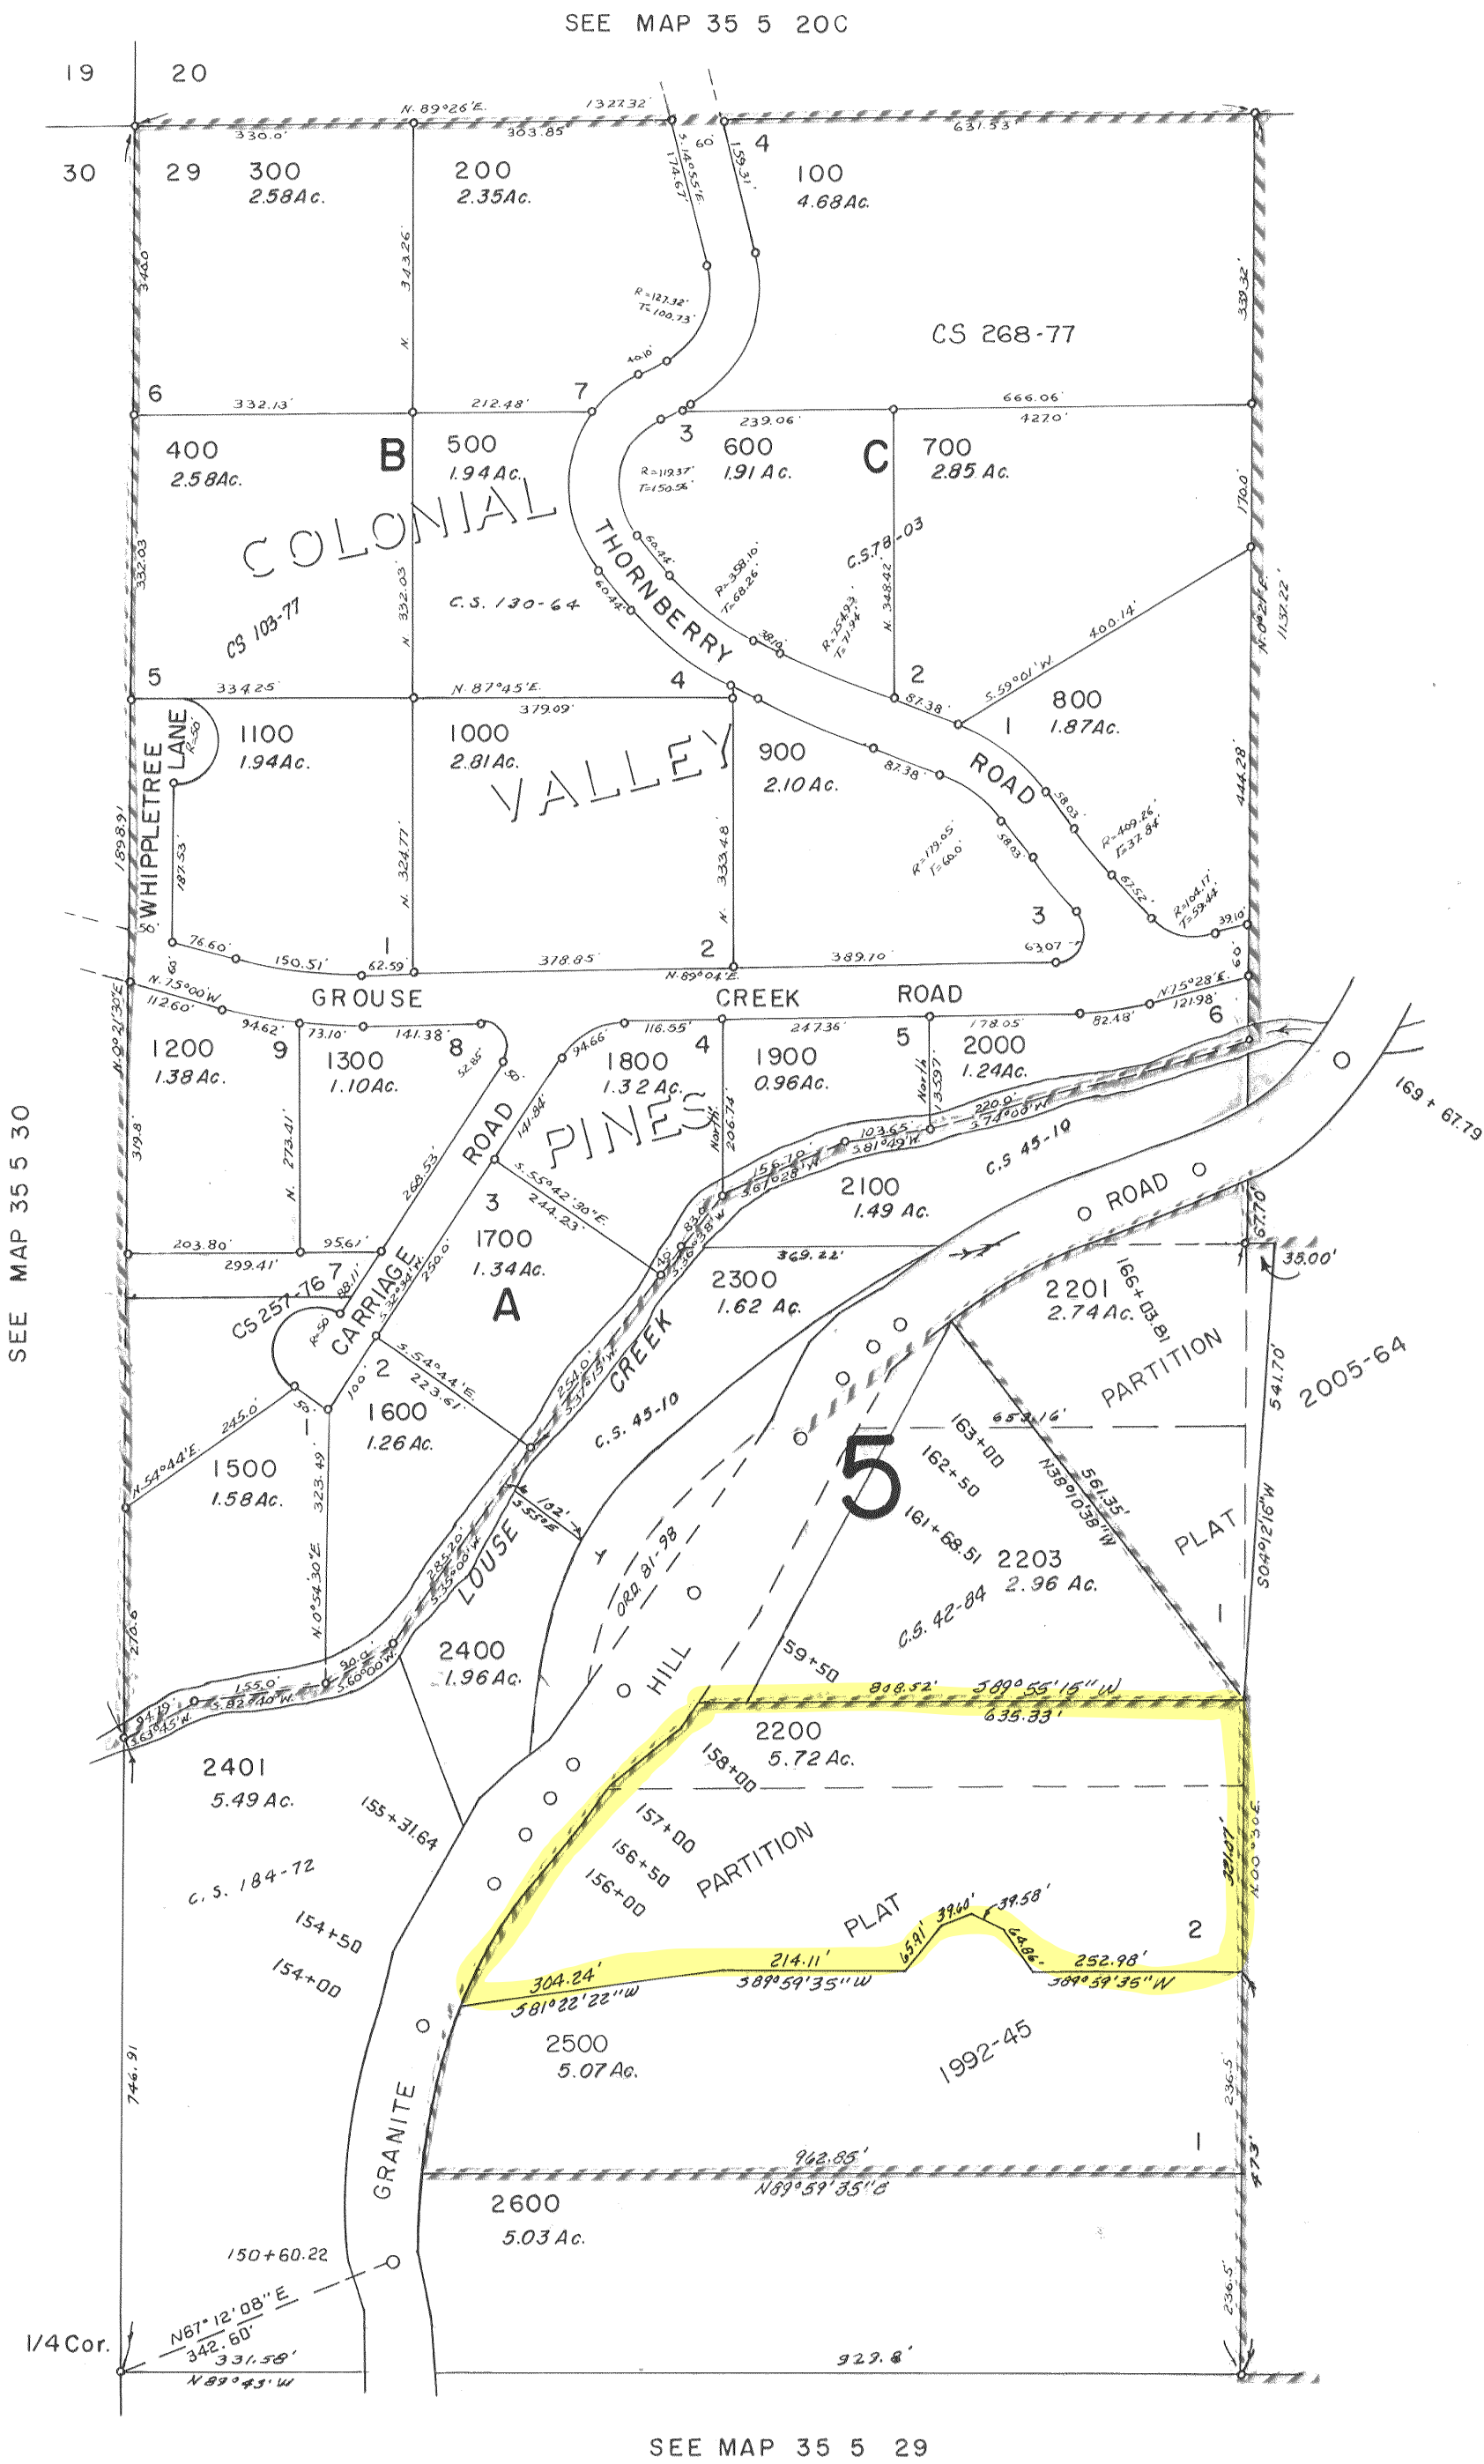

1/4 Cor.

CANCELLED T.L.
1400
1401
2202-90
2290
2590

SEE MAP 35 5 29

JOSEPHINE COUNTY DEVELOPMENT PERMIT

NON-REFUNDABLE 2167

FEE: \$275. CHECK: _____ CASH: 08-387

PERMIT NUMBER: _____

TWN: 35 RNG: 05 SEC: 29 QQ: B0 TAXLOT 2200

SITUS: 2575 GRANITE HILL RD

ACRES: 5.72



ZONE: RR5

Applicant: J & L Builders**Applicant Phone:** 659-1235**Applicant Address:** _____**Owner:** WALGAMOT FAMILY TRUST WALGAMOT, FRANK U**Owner Address:** 2575 GRANITE HILL RD GRANTS PASS, OR 97526-9749**SPECIAL REQUIREMENTS**

- | YES | NO | |
|--------------------------|-------------------------------------|---|
| ☐ | ☐ | Assigned Situs/Space Number _____ Address Card _____ |
| ☐ | ☒ | County Road* _____ State Highway* _____ Other/NA _____ Access Permit in File _____ |
| ☐ | ☒ | Violation - Development Permit to resolve violation(s) _____ Comment: _____ |
| ☐ | ☒ | Approximate Flood Hazard Area - Professional Certificate in File _____ NA _____ Reason: _____ |
| ☐ | ☒ | Floodway Fringe - Base Flood Elevation _____ ft. NA _____ Reason: _____ |
| ☐ | ☒ | Floodway - Approved Engineer's "No-Rise" Study in File _____ NA _____ Reason: _____ |
| ☐ | ☒ | LOMA (Letter of Map Amendment) on file |
| ☐ | ☒ | Scenic Waterway - BLM Authorization in File _____ |
| ☐ | ☒ | Stream - Name _____ Class 1 Stream _____ Class 2 Stream _____ |
| ☐ | ☒ | Wetland - Division of State Lands Authorization in File _____ NA _____ Reason: _____ |
| ☐ | ☒ | Nesting Site - ODF&W Authorization in File _____ NA _____ Reason: _____ |
| ☐ | ☒ | Erosion Hazard - Plan in File _____ NA _____ Reason: _____ |
| ☐ | ☒ | Fire Hazard - Plan in File _____ NA _____ Reason: _____ |
| ☐ | ☒ | Aggregate - Restrictive Covenant/Aggregate Impact Area Agreement in File _____ |
| ☐ | ☒ | Airport Overlay - Declaration in File _____ NA _____ Reason: _____ |
| ☐ | ☒ | Enterprise Zone |
| ☐ | ☒ | Historical - Historical Committee Review _____ |
| ☐ | ☒ | Part of Total - map no. : _____ Acres: _____ |
| ☐ | ☐ | Site Review Conditions - Comment: _____ |

EXISTING STRUCTURESROOF COVER COMP SHINGLE
MAIN AREA (2 BEDROOMS)
DECK FIR
GARAGE ATTACHED
CONCRETE FLAT WORK**PROPOSAL**Proposed is a 19' x 16' living room
addition to the existing dwelling.**SETBACKS**Front Setback: 30
Side Setback: 10
Rear Setback: 25
Stream Setback: NA
Height: 35 ft.**Additional Terms:** _____

OTHER PERMITS REQUIRED: *ACCESS PERMIT REQUIRED FROM COUNTY PUBLIC WORKS DEPT OR STATE HIGHWAY DIVISION. ALL STRUCTURES APPROVED BY THIS PERMIT MUST ALSO BE AUTHORIZED BY SEPARATE PERMITS FROM THE DEPARTMENTS OF BUILDING SAFETY AND ENVIRONMENTAL QUALITY. FAILURE TO COMPLY WITH THE TERMS OF THIS PERMIT WILL RESULT IN REVOCATION. FALSIFICATION OF INFORMATION IS A VIOLATION OF STATE LAW.

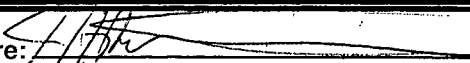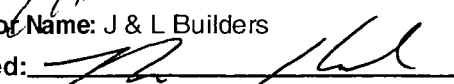Signature: 
Contractor Name: J & L Builders**Approved:** **Date:** 6-13-08**License#:** 131622**Date:** 6-13-08

NOTE: AUTHORIZED USES MUST BE UNDERWAY WITH ALL REQUIRED PERMITS WITHIN 1 YEAR FROM DATE OF ISSUANCE OF THIS PERMIT.

PLOT PLAN

35-03-29-80 +L2500

2200

MR. & MRS. WALSHAWOT

2575 GRANITE HILL RD.


STRUCTURE LOCATION
 ZONE RL MINIMUM SETBACKS
 FRONT 30 SIDE 10
 REAR 25 CENTERLINE
 STREAM N/A
 PLANNER Page 1

NON-BEDROOM ADDITION

I / We certify this addition or alteration will not result in additional bedrooms or sewage flow. No structure will be within 5' of the septic tank or 10' of the drainfield. The septic system is not surfacing, failing, or malfunctioning.

[Signature] 06/13/08
 Applicant Signature / Date

DEPT. OF ENVIRONMENTAL QUALITY
 GRANTS PASS BRANCH

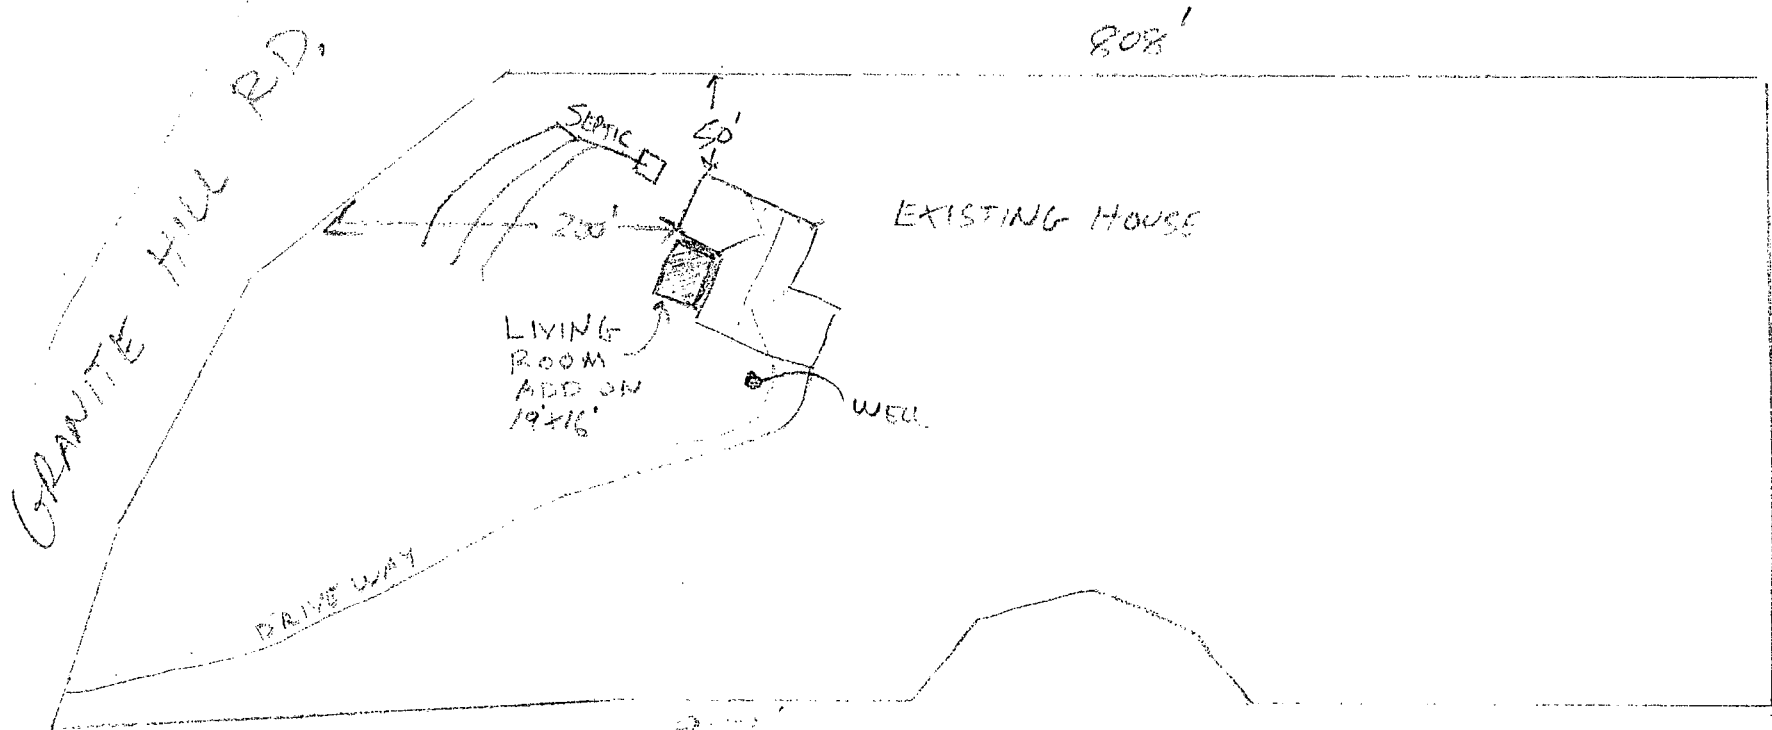

J & L Builders, Inc.
 P.O. Box 936
 Grants Pass, OR 97528

[Signature]

1" = 400' APPROX

6-12-08

JOSEPHINE COUNTY DEVELOPMENT PERMIT

FEE: \$25 — CHECK: 0311 CASH: _____

PREVIOUS PERMIT # _____

T 35 R 5 SEC 29 - 2 TL 2200ZONE: RR-5OWNER: Frank + Shigebo Walgamot PHONE: _____MAILING ADDRESS: 2575 Granite Hill Rd GP

SPECIAL REQUIREMENTS

- YES NO
- ☐ ☒ Identified Wetland. 30 Day Notice to Oregon Division of State Lands Required (____).
- ☐ ☒ Non-Surveyed Flood Hazard (Zone A). Professional Certificate in File (____).
- ☐ ☒ Flood Plain Hazard. Required Homesite Elevation is one foot above _____ feet.
- ☐ ☒ Floodway Hazard. Approved Engineer's "No-Rise" Study is in File (____).
- ☐ ☒ Scenic Waterway Restriction. BLM Authorization in File (____).
- ☐ ☒ Overlay Restrictions: 50' Firebreak (____) 1500' Aggregate Setback (____) Erosion Control Plan (____).
- ☐ ☒ Stream Setback: 50' from Class I Stream Bank (____) 25' from Class II Stream Bank (____).
- ☒ ☒ House Number (2575) Sign Posted at County Right-of-Way.
- ☐ ☒ Surfaced Driveway Required (*Urban Area Only*).
- ☐ ☐ Site Review Conditions Part of This Permit.

DEVELOPMENT

EXISTING

PROPOSED

Vacant Land: ☒ Yes ☐ No Parcel Size: 5.72 Bldg. Height: _____

Conventional Residence ☒ BR 3 ☐ BR 3

Manufactured Housing ☐ BR _____ ☐ BR _____

Garage ☐ _____ ☐ _____

Addition to Exist Bldg ☒ converting living room

Home Occupation ☐ to master bedroom

Resource Bldg ☐ + bath

Multi-Family ☐ _____

Commercial ☐ _____

Industrial ☐ _____

Other ☒ deck ☐ _____

☒ shed

SETBACK REQUIREMENTS: Front: _____ Side: _____ Rear: _____ Street Centerline: _____

ADDITIONAL TERMS: * Changing walls around - no added square footageACCESS: ☐ Private ☐ Private Maint County Rd ☐ Non-Maint County Rd ☐ Maint County Rd* ☐ State Highway*
*Access permit required from County Public Works Dept or State Highway Division

OTHER PERMITS REQUIRED: ALL STRUCTURES APPROVED BY THIS PERMIT MUST ALSO BE AUTHORIZED BY SEPARATE PERMITS FROM THE DEPARTMENTS OF BUILDING & SAFETY AND ENVIRONMENTAL QUALITY.

FAILURE TO COMPLY WITH THE TERMS OF THIS PERMIT WILL RESULT IN REVOCATION. FALSIFICATION OF INFORMATION IS A VIOLATION OF STATE LAW.

Signature: [Signature] ☐ Owner ☒ Contractor (Lic # 131622)Approved: [Signature] Date: 8-3-00

NOTE: THIS PERMIT IS VALID FOR 1 YEAR. AUTHORIZED USES MUST BE UNDERWAY WITH ALL REQUIRED PERMITS WITHIN 1 YEAR FROM DATE OF ISSUANCE.

THIS PERMIT EXPIRES ON: 8-3-01PERMIT #: 00-684


(Rev. 1/99)

COPIES: WHITE—Planning ■ CANARY—Dept Environmental Quality ■ PINK—Bldg & Safety ■ GOLDENROD—Applicant

T 35 R 5 SEC 29 - 2 TL 2200 Address 2575 Granite Hill Rd

NON-BEDROOM ADDITION

I / We certify this addition or alteration will not result in additional bedrooms or sewage flow. No structure will be within 5' of the septic tank or 10' of the drainfield. The septic system is not surfacing, failing, or malfunctioning.

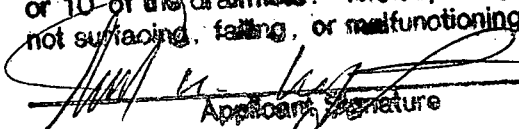
Applicant Signature

Date 8-3-00 1 bed & bedroom
only

DEPT. OF ENVIRONMENTAL QUALITY
GRANTS PASS BRANCH

DATE: 8-3-00


T 35, R 5, SEC 29-2, TL# 2200

NAME: Walgamot

ADDRESS: 2575 Granite Hill

FRANK & MICKY WALGAMOT
2575 GRANITE HILL RD
C.P. 97526

PLOT PLAN

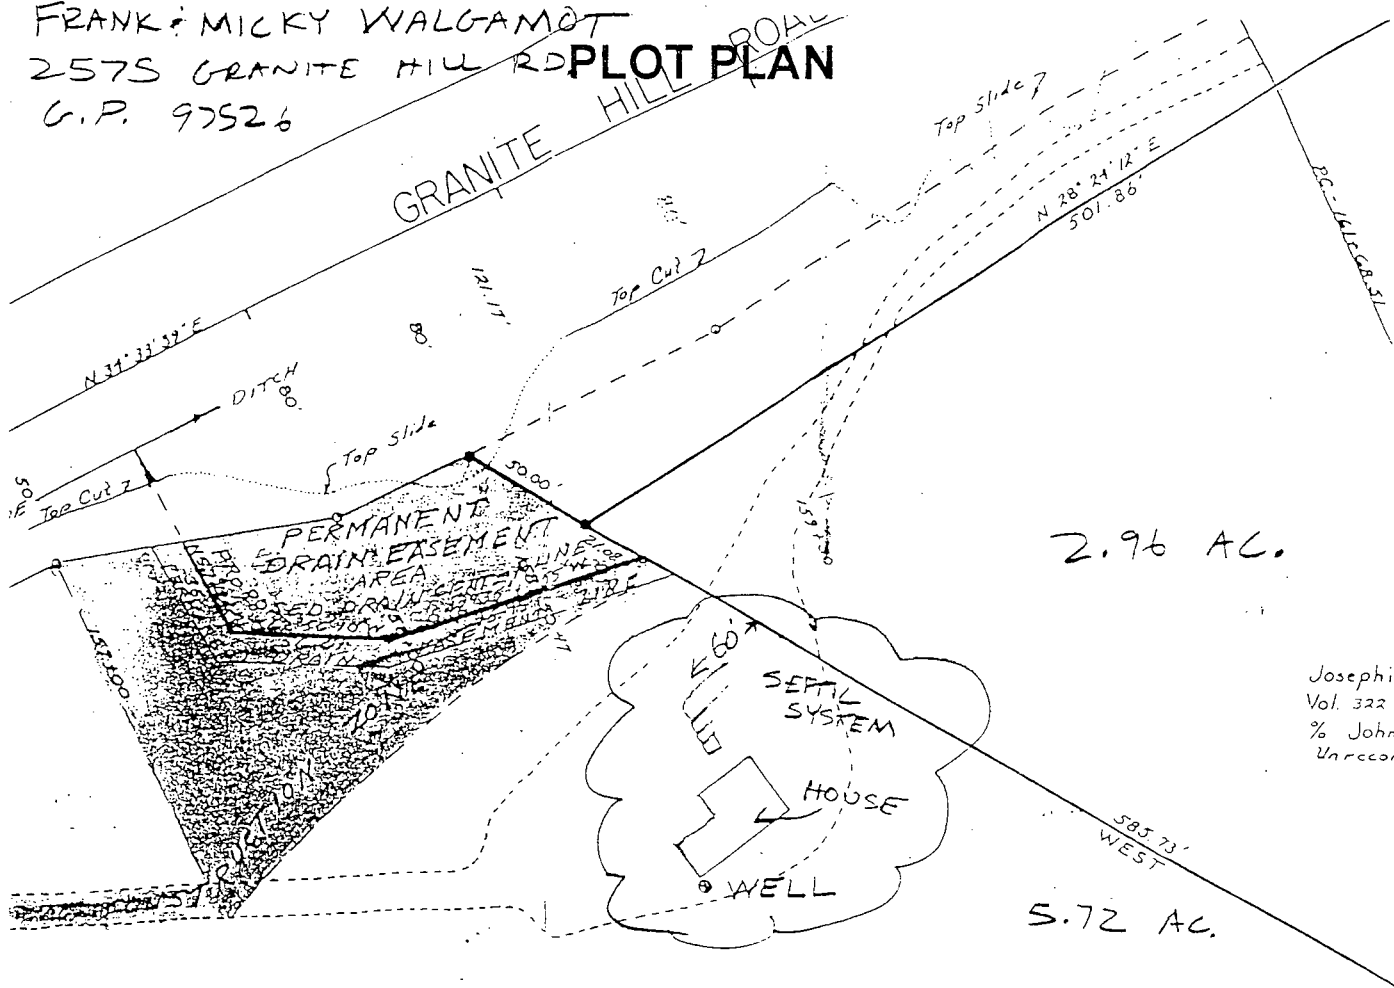

PLAT

STRUCTURE LOCATION:

ZONE RR-5 MINIMUM SETBACKS:

FRONT 30' SIDE 10'

REAR 25' CENTERLINE 60'

STREAM

PLANNER

SIGNATURE: [Signature]

SEE MAP 35 5 30

11B

15

LOUSE

GRANITE

RR5

SEE MAP 35 5 29

AIRPORT ZONE(S): NONE

FEMA: 227

TOPO: SEXTON MTN. & GRANTS PASS

CAC: COLONIAL VALLEY

\\planat\maps\counter\3505\3505292.apr 6/16/97 mds

1200
1.38 Ac

1300
1.10 Ac

1800
1.32 Ac

1900
0.96 Ac

2000
1.24 Ac

555

505

1700
1.34 Ac

2100
1.55 Ac

CARRIAGE ROAD

ROAD CREEK

1500
1.58 Ac

1600
1.26 Ac

2300
1.27 Ac

2201
2.52 Ac

12D

2202-90
0.75 Ac

2203
2.90 Ac

2400
1.96 Ac

2202-90

2571 79F

2200
5.72 Ac

2401
5.49 Ac

2500
5.07 Ac

21F

2550

2600
5.03 Ac

12D

2500

11B

Josephine County Environmental Health Services
Josephine County Courthouse, Grants Pass, OR 97526

INSTALLATION LOCATION 2575 GRANITE HILL RD.

ZONE CLEARANCE 79-72 V

4/4/79

~~#7483~~

7483

Nº 10378

PROPERTY OWNER

LAAR, John

Disapproved 474-1289

MAILING ADDRESS

2575 Granite Hill Rd., Grants Pass, OR

Issued

TELEPHONE

97526

ZIP

INSTALLATION ADDRESS

2575 GRANITE HILL ROAD

DESCRIPTION OF PROPERTY

T 35

R 5

SEC 29-2

TL

2202 Expires new syst. on 7/22/02

Acreage 3.71

Subd. 561

Lot

Blk

Installed

PERMIT REQUESTED

New XX

Repair

Hook-Up

Other

BUILDING INFORM.

Home XX

Mobile Home

No. of Bdrms. 3

Commercial

No. Employees

Other

PROPOSED WATER SUPPLY

Private XX

Community

Public

Other

\$5.00 Ck. 4/5/79 fa

Permit Fee Paid / Clerk / Date

Applicants Signature

SUBSURFACE SEWAGE DISPOSAL PERMIT: **Approved ✓

Disapproved

MINIMUM SEPTIC TANK CAPACITY IN GALLONS: 1000

TRENCHES:

Square Feet

480

Width

24"

Length

240

Depth

24-30"

Equal

Loop

Serial

✓✓✓

Date of Issue

3/5/79

Sanitarian

Date

3-5-79

THIS PERMIT EXPIRES ON:

3/5/80

**SPECIAL INSTRUCTIONS AND CONDITIONS:

is 2 bedroom!

Maximum size dwelling allowed

DATE INSTALLATION APPROVED

4-24-79

SIGNED

CD Costas

CERTIFICATE ISSUED


THIS PERMIT AND THE ENCLOSED RECORD FORM MUST BE POSTED IN A

CONSPICUOUS PLACE AT THE BUILDING SITE WHEN THE FINAL INSPECTION IS REQUESTED.

STATE OF OREGON
DEPARTMENT OF ENVIRONMENTAL QUALITY
SUBSURFACE SEWAGE SYSTEM
CERTIFICATE OF SATISFACTORY COMPLETION

Property Owner John Laar Permit Number 10378
T. 35 R. 5 Sec. 29-2 Tax Lot/Acct. No. 2202 Date of Final Insp. 4-24-79
Loc./Road 2575 Granite Hill Rd Approved By CD Costanzo
Installer Dumbey Title RS
Disposal Trenches: _____ Square Ft. _____ Lineal Ft. _____
Tank Size: 1000 Gallons. System Designed to Serve 2 bedroom Maximum!!

Plot Plan:

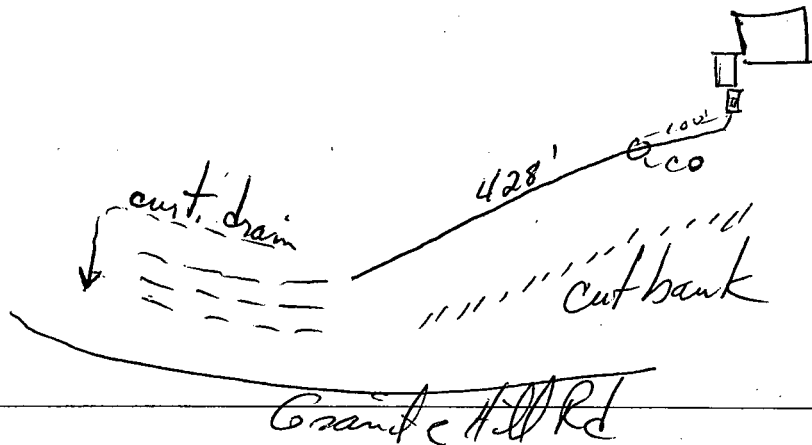

DEQ/WQ-402 1/78

STATE OF OREGON
DEPARTMENT OF ENVIRONMENTAL QUALITY
SUBSURFACE SEWAGE SYSTEM INSTALLATION

The Inspection of this Subsurface Sewage System has Produced the Following Violations:

① Need utility
assessment for sewage system on next lot
② Need grout
to ground surface on curtain drain in area of surface drain
(see drawing)

Under the provisions of the OREGON ADMINISTRATIVE RULES, all violations listed above must be corrected and a **CERTIFICATE OF SATISFACTORY COMPLETION** must be issued prior to use of this system. When corrections have been completed, call for inspection.

PERMIT NO. 10378

INSPECTION:

TIME 2:30

DATE 4-5-79

BY CD Costanzo
(SIGNATURE)

CONTACT:

Chuck Costanzo
476-8881
ext 333

JOSEPHINE COUNTY HEALTH DEPT.
ENVIRONMENTAL HEALTH SERVICES
RECORD OF SEWAGE DISPOSAL SYSTEM

To Be Completed By Installer:

Permit Issued to: Name _____ Installer's Name Ed Ownbey
Mailing Address _____ Permit Number 10378
Property Address 2575 Granite Hill Rd

Total Number: Living units _____ bedrooms _____ baths _____ basement: yes _____ no _____

Water Supply: Public system _____ individual _____ community _____


Septic Tank: Distance from well _____ feet Material concr
Total liquid capacity 1000 gal.

Drainfield: Total linear feet _____ ft.
Total square footage _____ ft.
Width of trench or bed _____ ft.
Distance between drain lines _____ ft.
Type of rock filter material _____
Depth rock over drain line _____ in.
Depth rock beneath drain line _____ in.
Transit used: yes _____ no _____
Distance of well from subsurface disposal unit _____ ft.

Seepage Pit: Depth _____ width _____ length _____
Square feet _____ lined (dry well) _____ or gravel filled (pit) _____

Privy: Ground Excavation: depth _____ width _____ length _____
Cubic feet _____

SKETCH OF ACTUAL SYSTEM AS CONSTRUCTED

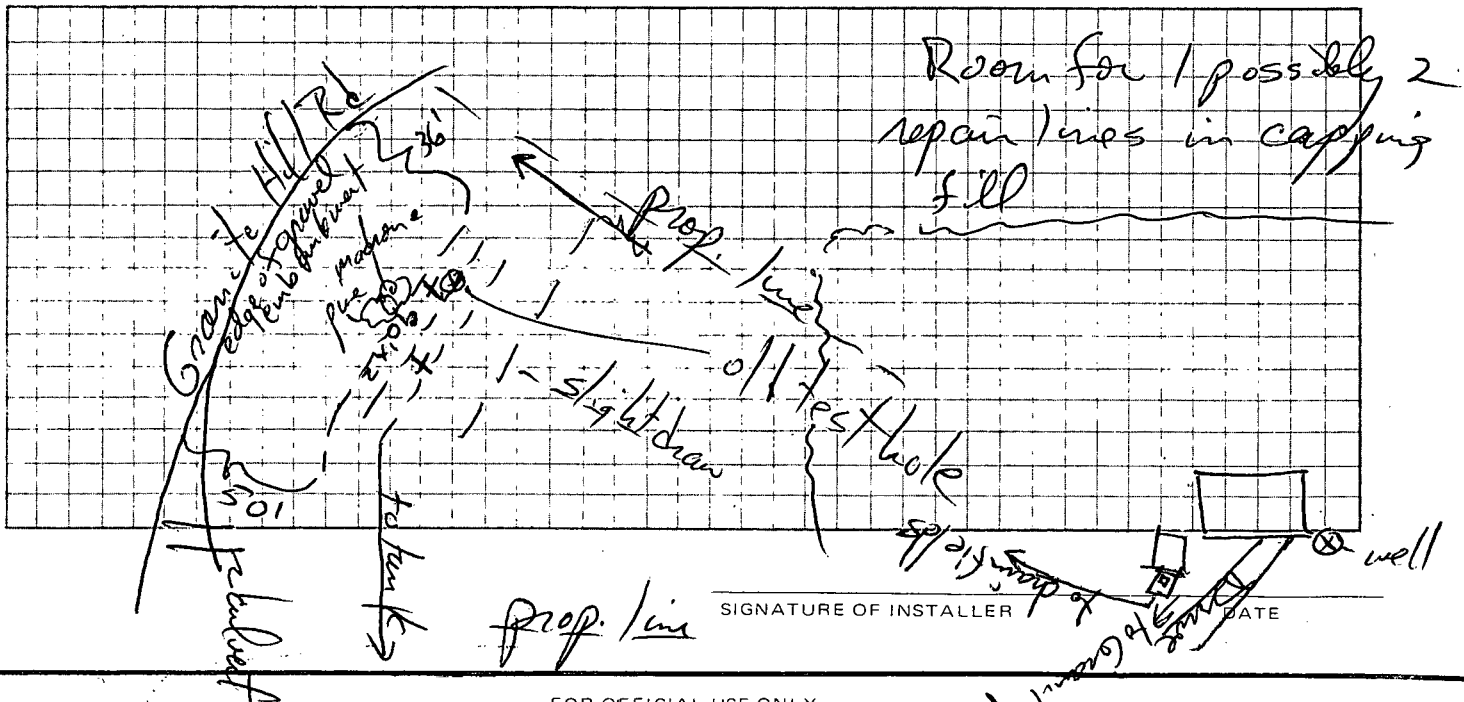

FOR OFFICIAL USE ONLY

System meets all codes and apparently WILL ✓ 4/24/79 WILL NOT _____ function satisfactorily and is therefore
APPROVED _____ for occupancy. DISAPPROVED _____

Remarks

① No utility easement ② bring gravel to ground surface on portion
drain in area of 5' x 9' drain ③ system was installed before
permit was issued ④ 14\"/>

date

4-5-79


Sanitarian

CD Cos

PLOT PLAN

INSTRUCTIONS:

1. DRAW A DIAGRAM OF YOUR PROPERTY in the space provided below, showing lot shape, keeping it directional; showing the location of the test-holes and any existing or proposed wells, driveways, streams, existing structures, or anything else that would have any bearing on the septic system. (Test holes must be a minimum of 6 ft. deep and within 75 ft. of each other.)
2. SHOW THE DISTANCE from two adjacent property lines to one of the test-holes and the distance between the test-holes.
3. FLAG THE ENTRANCE to the property and all test holes with flagging provided. Put your name on flagging at the property entrance. If test holes are hard to locate because of brush, distance, etc., place flags leading to the holes from the entrance.
4. RETURN PLOT PLAN AND ZONE VERIFICATION with fee when applying for a Site Evaluation for Septic approval.

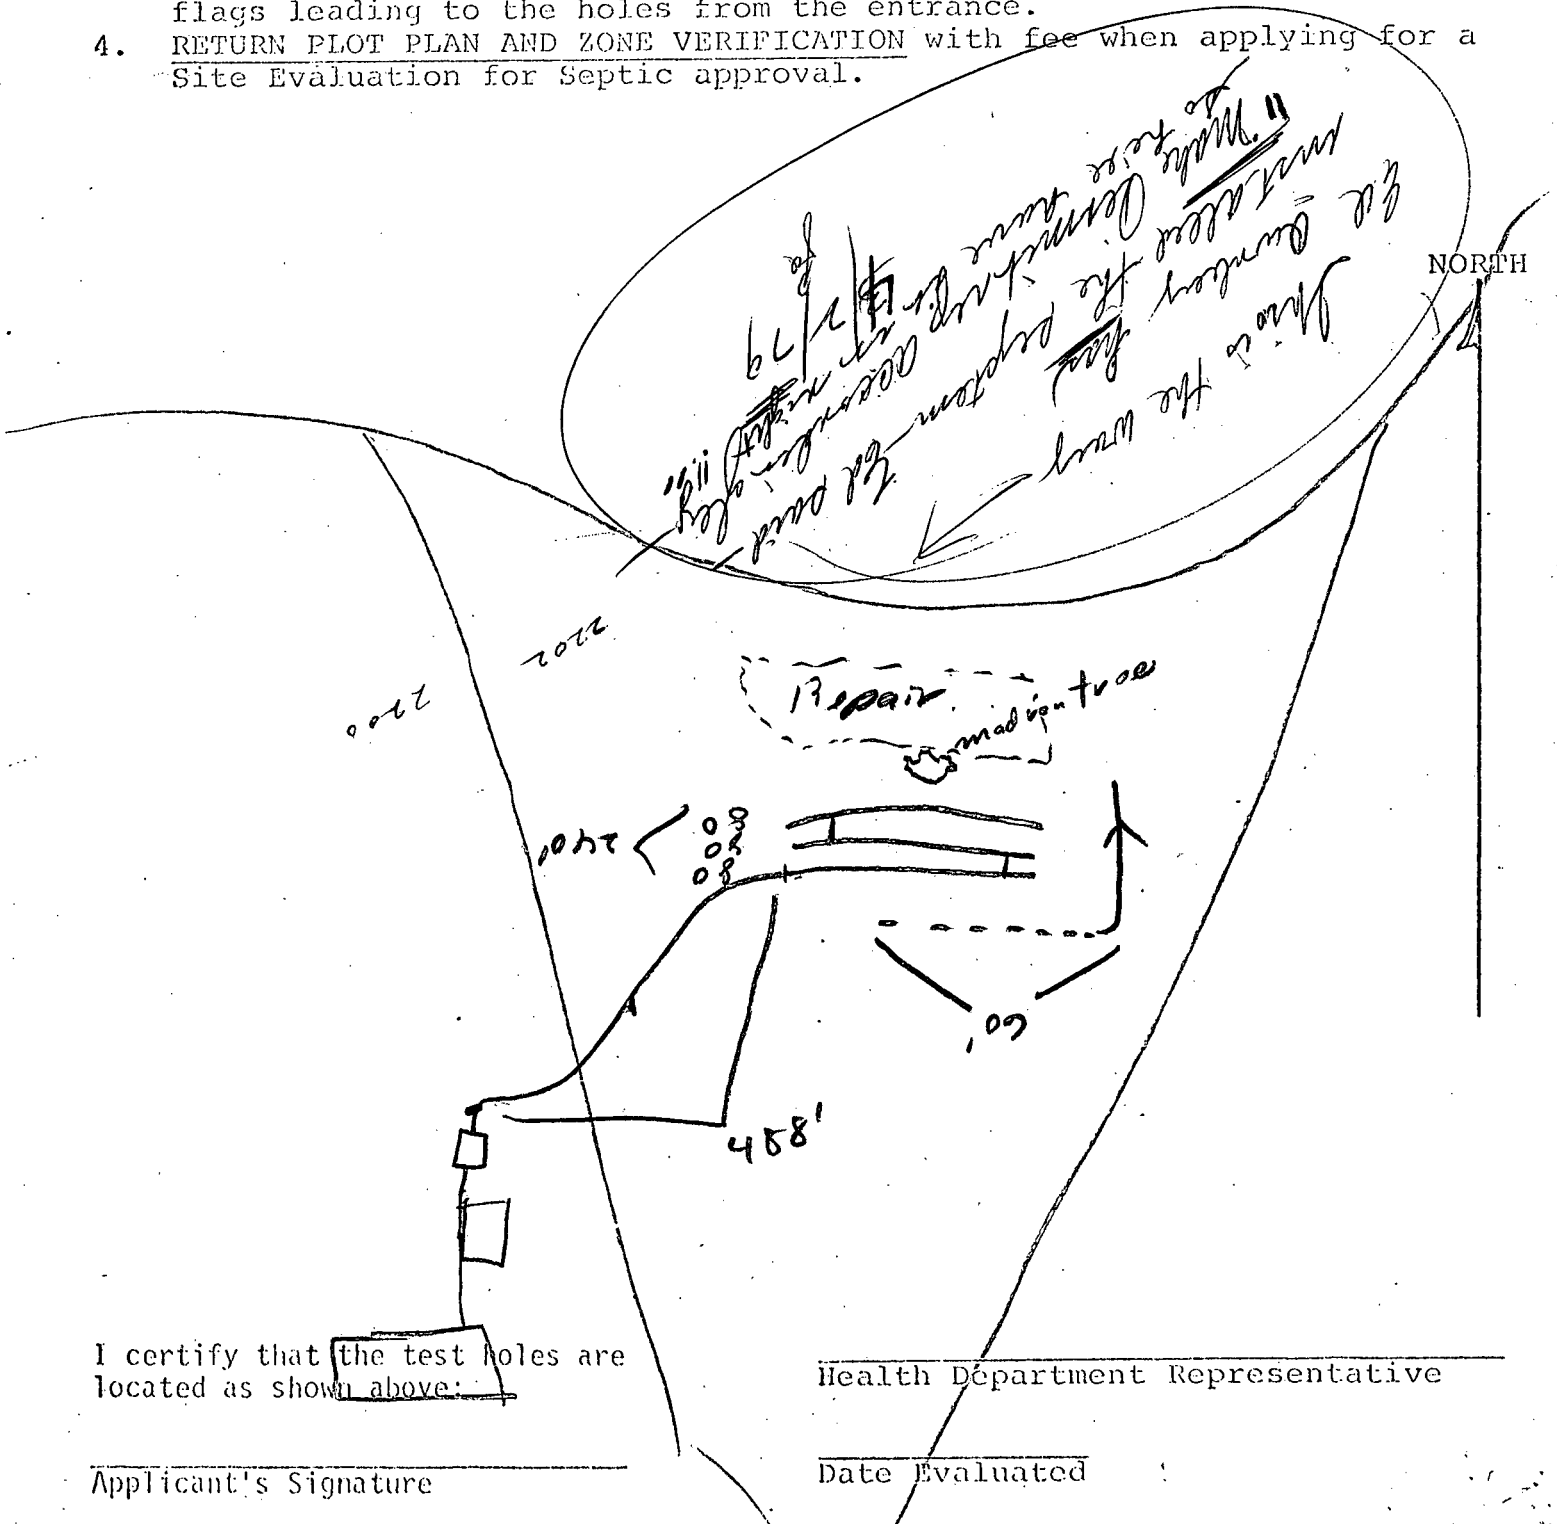

I certify that the test holes are located as shown above:

Applicant's Signature

Health Department Representative

Date Evaluated

Site No.

Permit No.

Date Submitted

EASEMENT AGREEMENT

16469

THIS AGREEMENT, made this 3 day of April,
19⁷⁹, by and between John Laar & Barbara Ellen Laar,
John Laar & Barbara Ellen Laar
grantors and _____
grantees;

WHEREAS, grantees are the owners of the following
described real property in Josephine County, Oregon,
to-wit:

#35-5-sec29-B TL#2200

The grantors, in consideration of ONE DOLLAR (\$1.00)
and other valuable consideration, receipt of which is hereby
acknowledged, do hereby grant and convey to the grantees,
their heirs, successors and assigns, a nonexclusive easement,
subject to liens and encumbrances of record, in the following
described real property in Josephine County, Oregon,
to-wit:

35-5-sec 29B TL#2202

for the construction, maintenance, use and repair of an indi-
vidual water-carried subsurface sewage disposal system (herein-
after called "system") appurtenant to the above-described
property of grantees.

Grantors, for themselves and their heirs, successors and
assigns, covenant and agree to and with the grantees, their
heirs, successors and assigns, that the above-described property

of grantors shall not be used for any purpose detrimental to said system or contrary to laws and rules of governmental agencies applicable or related to said system.

IN WITNESS WHEREOF, the parties hereto have executed this agreement as of the date first hereinabove written.

same as Grantee

same as Grantees

(Grantors)

(Grantees)


STATE OF OREGON

County of Josephine

) ss.

April 7, 1979

Personally appeared the above-named John Laar & Barbara Laar, grantors, and acknowledged the foregoing instrument to be their voluntary act. Before me:

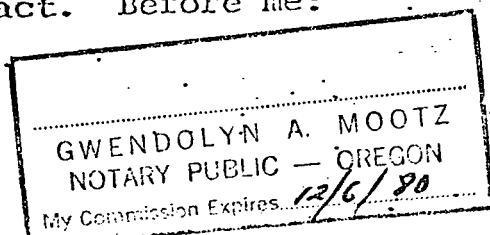

Gwendolyn A. Mootz
Notary Public for Oregon
My commission expires: 12/6/80

STATE OF OREGON

County of _____

) ss.

, 19____


Personally appeared the above-named _____, grantees, and acknowledged the foregoing instrument to be their voluntary act. Before me:

Notary Public for Oregon
My commission expires: _____

16459

State of Oregon,) ss. No. _____
County of Josephine,)
I, County Clerk and ex-officio Recorder
of Conveyances, in and for said County,
do hereby certify that the within instru-
ment was received for record at

APR 5 '79 AM

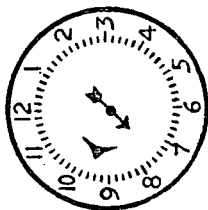

COUNTY CLERK
JOSEPHINE COUNTY OREGON

and
Recorded

at Page _____ of Vol. _____

DEED

Records of Josephine County, Oregon.

MAXINE FOSTER Co. Clerk

By Maxine Foster Deputy

20M

Fee \$ 4.00

Tarian Date _____

m/m Laar
2575 Granite Hill Road
Grant Pass. Oregon

Josephine County Health Department

Street address of installation (If no street address, describe specific location)

Property Owner:

Telephone:

Mailing Address:

street

city

State

DESCRIPTION OF PROPERTY: Township 35 Range 5 Section 292 Subsection _____ Code _____
(attach copy of assessor's map)Tax Lot Number: 2201 Name of Subdivision: _____Building site area in acres: 5 Dimensions of building site: Width _____ Depth _____PROPOSED WATER SUPPLY: Individual — Well (drilled ☒ driven _____ dug _____) Surface _____ Spring _____

Public: City _____ Community System (name) _____

BUILDING INFORMATION: Home ☒ Mobile Home _____ Number of Bedrooms 3

FHA or VA insured loan — yes _____ no _____ Commercial (type): _____

Garbage disposal unit — yes _____ no _____ Industrial (type): _____

SITE INFORMATION:	Indicate proposed layout using as much detail as possible.	
	*Acceptable	Unacceptable
1. Free Water Level		
2. Slope		
3. Soil Type		
4. Restrictive Layer		
5. Available Area		
6. Distances		
7. Other		
Other		

Indicate proposed layout using as much detail as possible.

Invalide due to road widening
CSK

THIS PERMIT MUST BE POSTED
ON BUILDING SITE

Fee Schedule: new system ~~\$5.00~~ \$50.00 repair \$2.00 _____ hook up to existing system \$1.00 _____ privy \$1.00 _____

Renewal \$5.00 _____ \$2.00 _____ Original Number _____

Permit Fee Paid

\$ 50.00 AS

X

Signature of Applicant

Checked by:

Clerk

Date issued:

Do Not Write Below This Line

Domestic Sewage Disposal Permit: Approved ☒ Disapproved _____

Minimum septic tank capacity in gallons:

Trench ☒ square feet 600 width 24" length 300 depth 24" 38" This PERMIT Expires On:

Equal _____ Loop _____ Serial _____

Seepage bed — square feet _____ width _____ length _____ depth _____

Seepage pit — cubic feet _____ width _____ length _____ depth _____

READ OTHER SIDE OF THIS PERMIT

*SPECIAL INSTRUCTIONS and CONDITIONS:

Install drain fields @ test holes
3x4 as shown on plot plan

MOBILE HOME EXTERIOR PLUMBING SHALL COMPLY WITH ORS 446.125 and OAR 44.490

Individual Sewage Disposal System Approved _____

sanitarian

Mobile Home Plumbing Approved _____

sanitarian

date

C ZONING CLEARANCE PERMIT C
Josephine County, Oregon

Date 27 Dec 76

Zoned Area IV

Owner Baker, Jack

Mailing Address 1025 Board Shanty Cr Rel

Property Description

Subdivision-Name _____ Lot _____ Block _____

Twp 35 Range 5 Section 29-2 Tax Lot 2201

Size or Lot-Width Var Depth Var Total Area 5 Ac

Fronting on Granite Hill Road

Proposed Use

Residential one only If mobile home, state size _____

Commercial _____ Industrial _____ Other _____

Does a residence presently exist on this parcel: Yes _____ No X

Subsurface Sewage Disposal System on this Parcel? Yes _____ No X

Provisions: _____

NOTE: PLEASE RETAIN THIS DOCUMENT & BRING IT WITH YOU WHEN APPLYING FOR
SEPTIC, SEWER, ELECTRICAL & BUILDING PERMITS.

Jack Baker
Signature of Applicant

District Classification SR-5 Minimum Lot Size 5 Ac

Any structure to be placed on the above mentioned lot must observe the following setbacks:

30 From Front Property Line (Note: Corner lots have 2 front yards)


60 From Center Line of Road 20 From Rear Property Line

10 From Left Side Property Line 10 From Right Side Property Line

Approved by: Wray A. Mays

No. 1104

PLOT PLAN

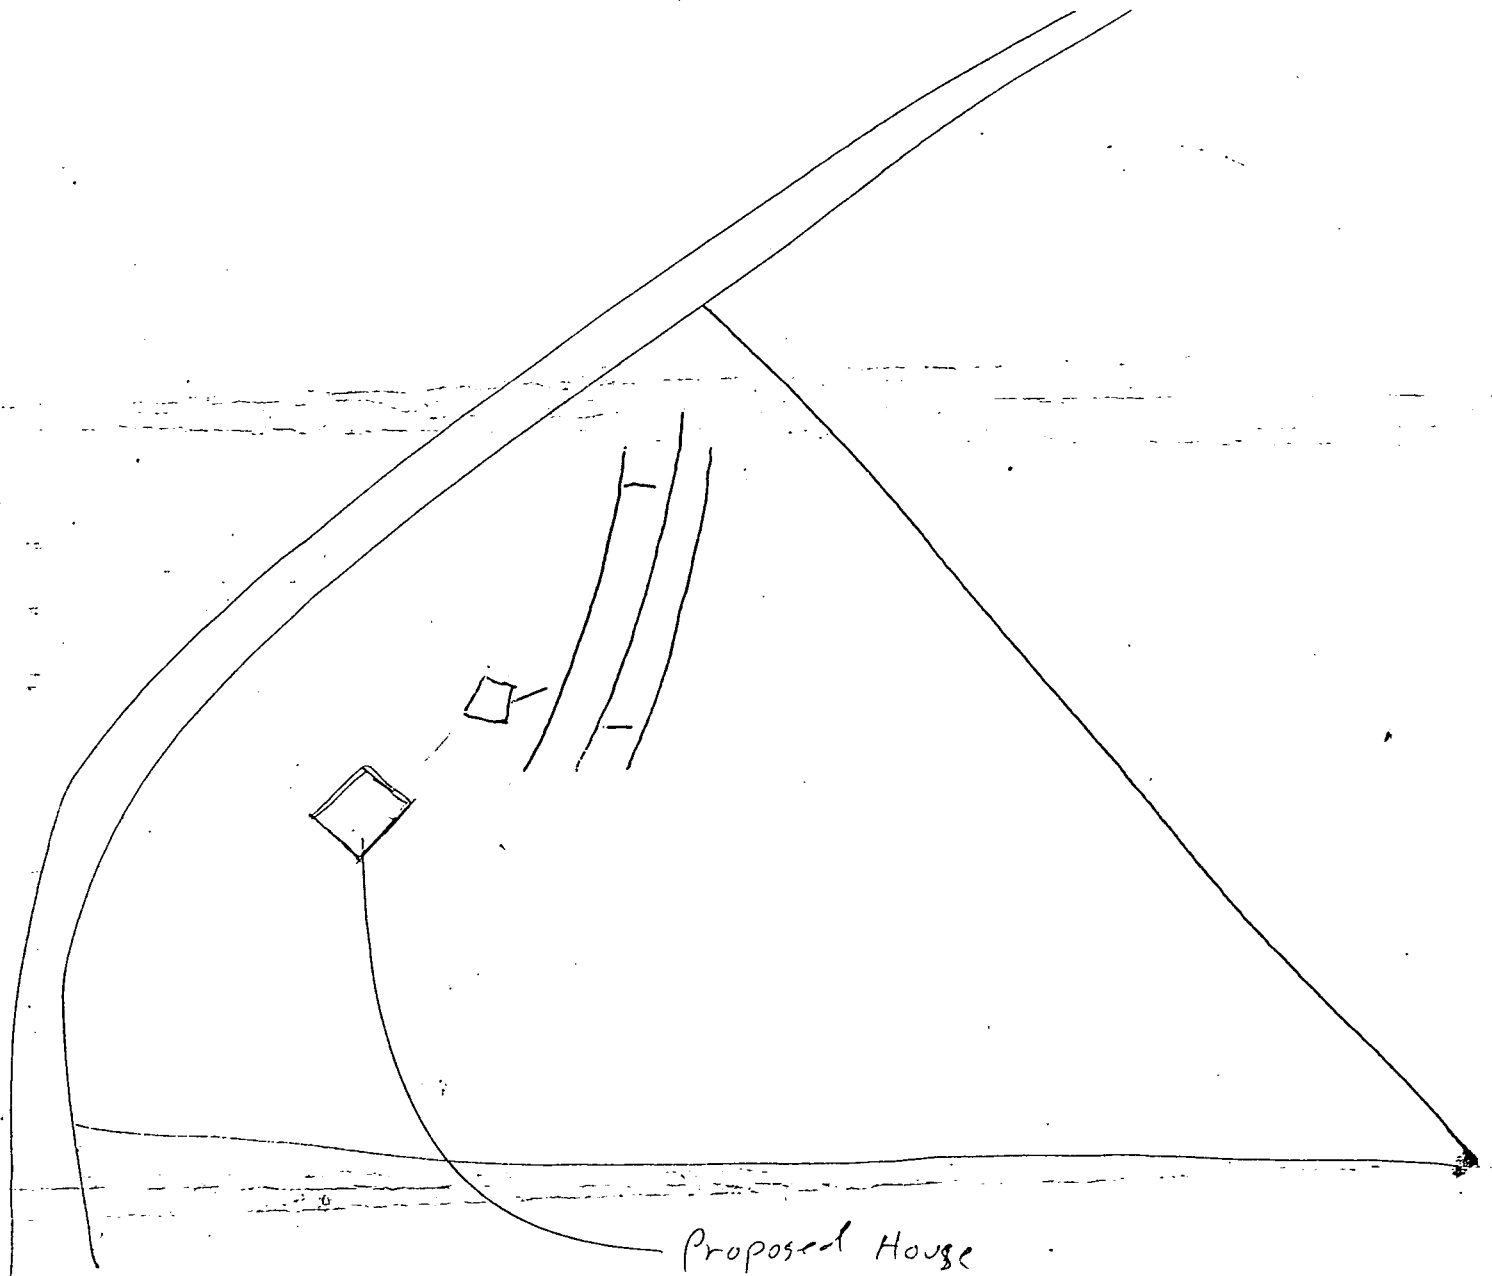


NORTH *
(* SHOW DIRECTION)

I/We certify that the proposed construction will conform to the dimensions and uses shown above and that no changes will be made without first obtaining approval.

Signature _____

JOSEPHINE COUNTY HEALTH DEPARTMENT

THE FOLLOWING IS A PLOT PREPARED BY THE HEALTH DEPARTMENT AND SHOWS THE LOCATION OF WHERE YOUR SEPTIC TANK SYSTEM SHOULD BE INSTALLED. IF THERE IS ANY QUESTION, PLEASE CONTACT THE APPROPRIATE REPRESENTATIVE AND HE WILL DISCUSS REASONS FOR THE RECOMMENDED LOCATION. SEE PERMIT FOR SPECIFIC INSTRUCTIONS.

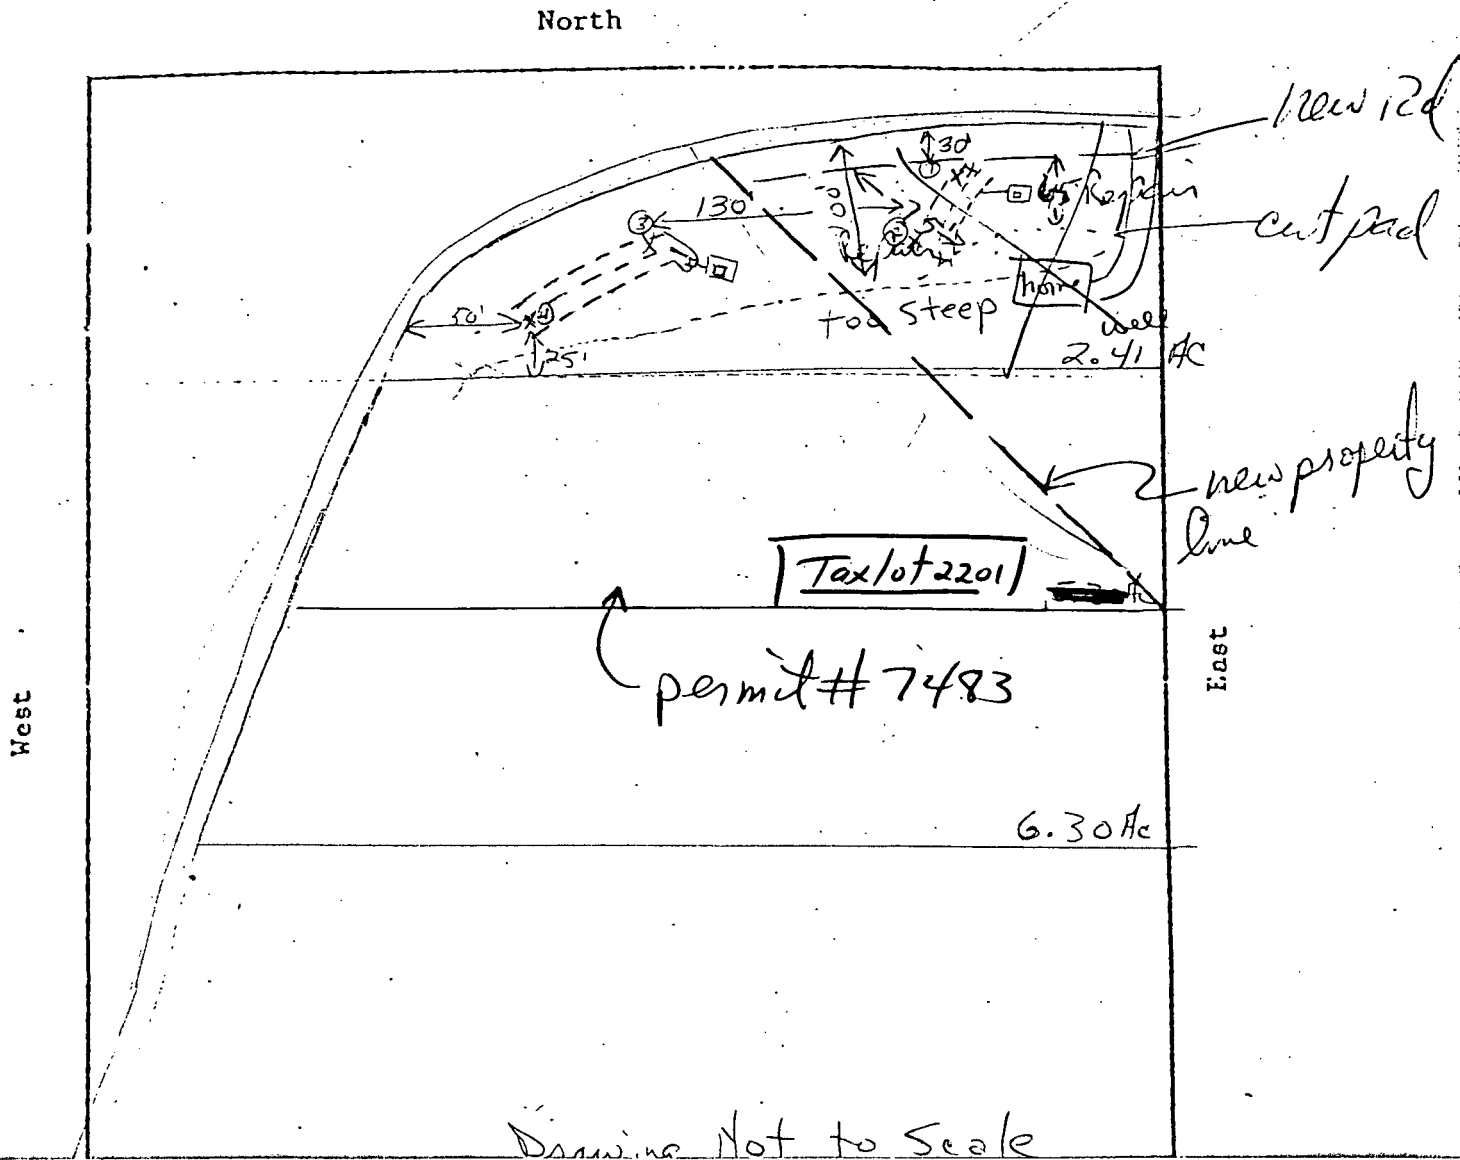

Approval is specific only for area designated on plot plan. No structures, excavation or traffic is allowed over this area and no wells within 100 ft. of this area.

Install drainfields at
test holes # 3 & 4

ODC 1/10/77

VERIFICATION OF ZONING PROVISIONS*

NOV 20 1975

Josephine County, Oregon

Date 3 Nov 75

Zoned Area V

Owner Withers, W D

Mailing Address 9 505 NE "7" Grp.

Property Description


Subdivision-Name _____ Lot _____ Block _____

Twp 35 Range 5 Section 29 B Tax Lot 2200

Existing Lot-Width Var Depth Var Total Area 13.76 Ac

Fronting on Granite Hill Rd

Number of Proposed Lots 3 Existing Residence: yes _____ no X

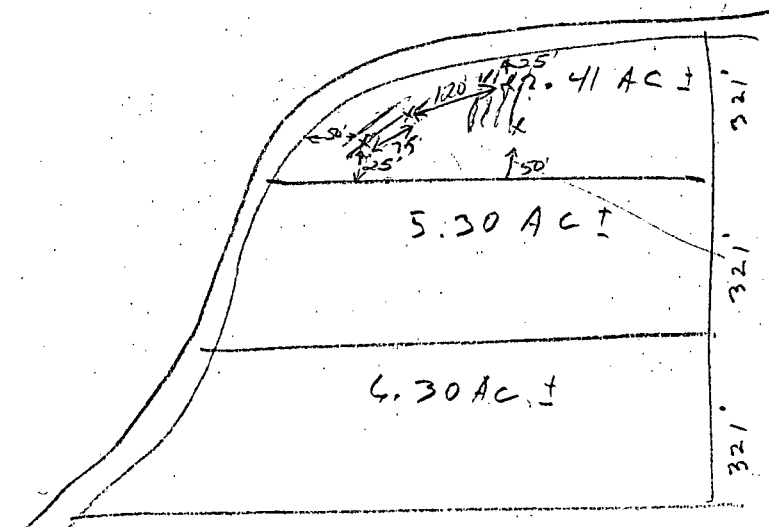

ALL PROPOSED LOTS TO RECEIVE SITE INVESTIGATIONS.

Proposed Lot Plan

W.D. Withers
Signature of Applicant
W.D. Withers


District Classification SR-5 Min. Road Frontage 25 ft

Min. Lot Size 5 Ac Min. Lot Width at Building Line 300 ft

Approved By: Ray W. Mendenhall

* FOR SITE INVESTIGATION ONLY

No. 279

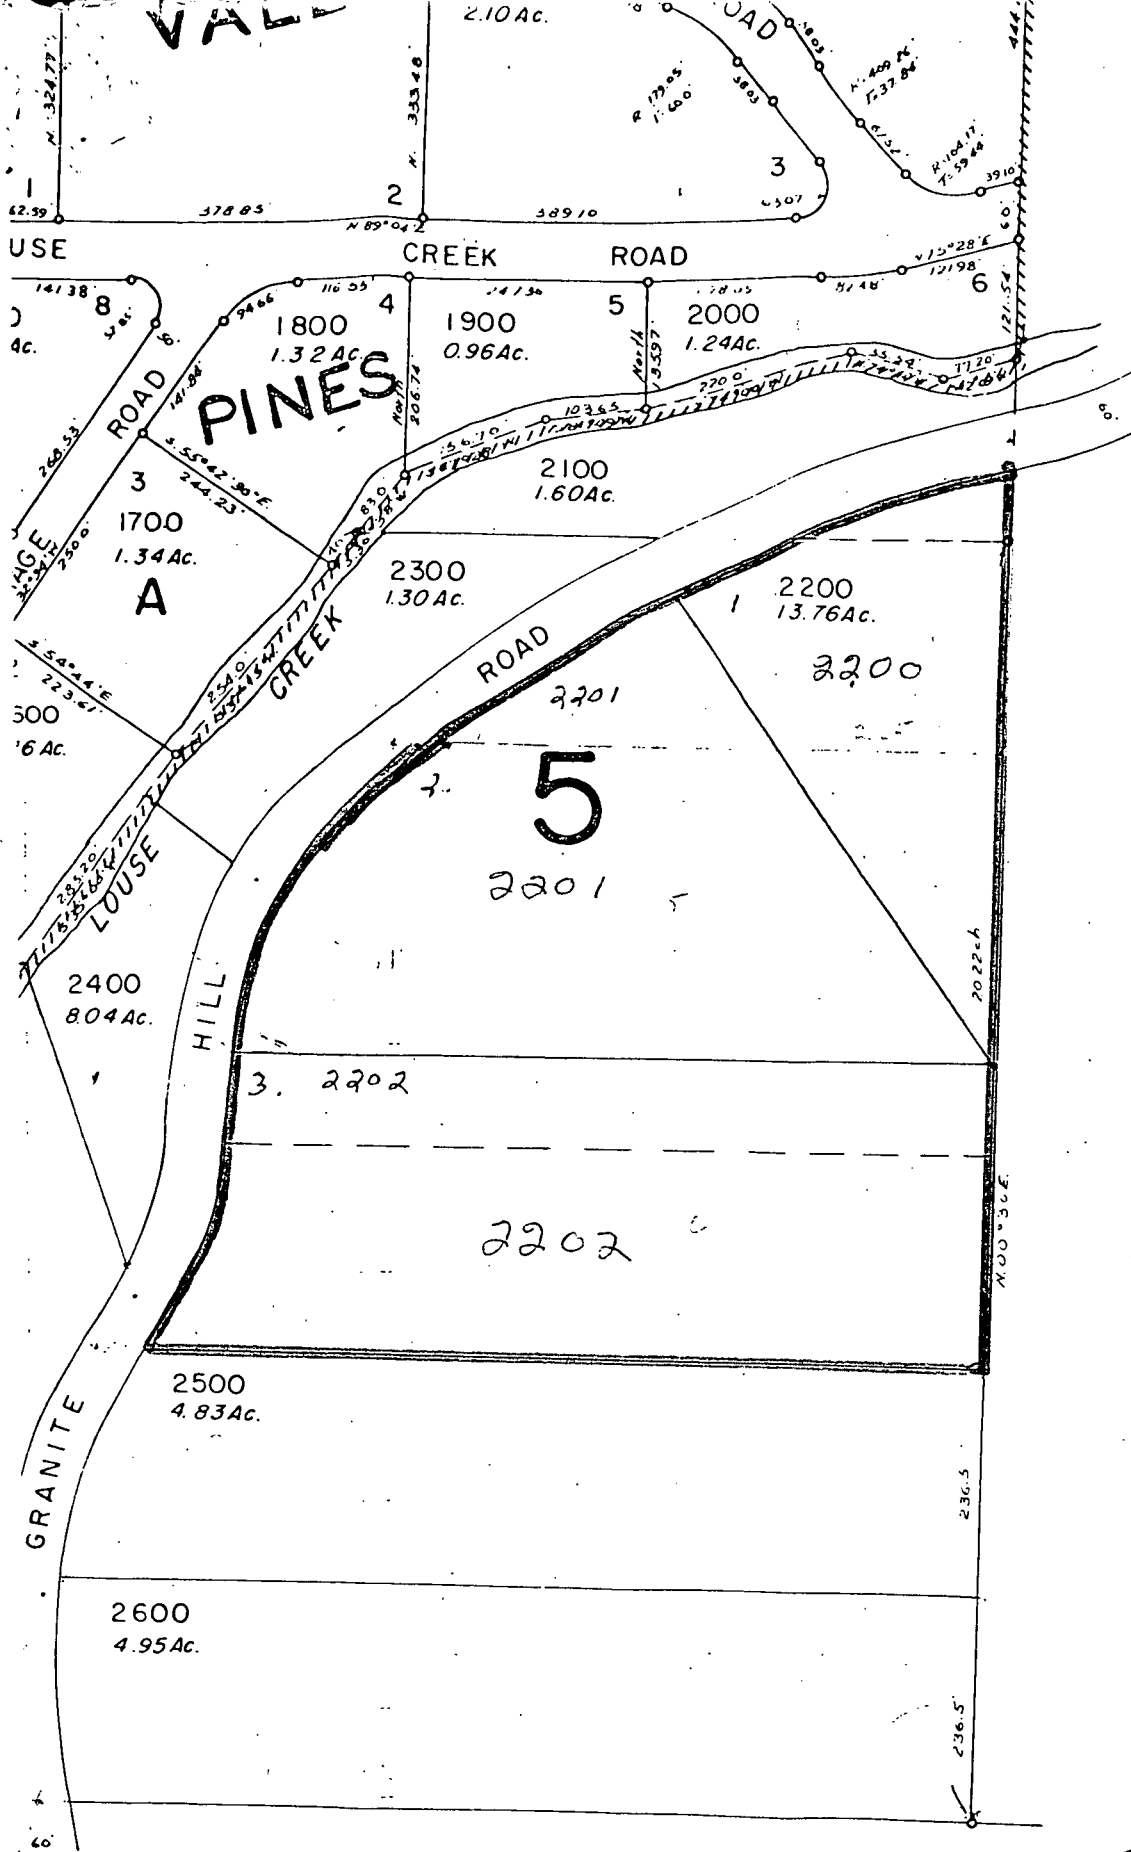


SEE MAP 35 5 29

35-5-29B
 THIS SKETCH IS FOR LOCATION PURPOSES ONLY AND NO LIABILITY IS ASSUMED FOR ANY VARIATIONS DETERMINED BY SURVEY
 JOSEPHINE COUNTY TITLE CO.

JOSEPHINE COUNTY HEALTH DEPARTMENT

THE FOLLOWING IS A PLOT PREPARED BY THE HEALTH DEPARTMENT AND SHOWS THE LOCATION OF WHERE YOUR SEPTIC TANK SYSTEM SHOULD BE INSTALLED. IF THERE IS ANY QUESTION, PLEASE CONTACT THE APPROPRIATE REPRESENTATIVE AND HE WILL DISCUSS REASONS FOR THE RECOMMENDED LOCATION. SEE PERMIT FOR SPECIFIC INSTRUCTIONS.

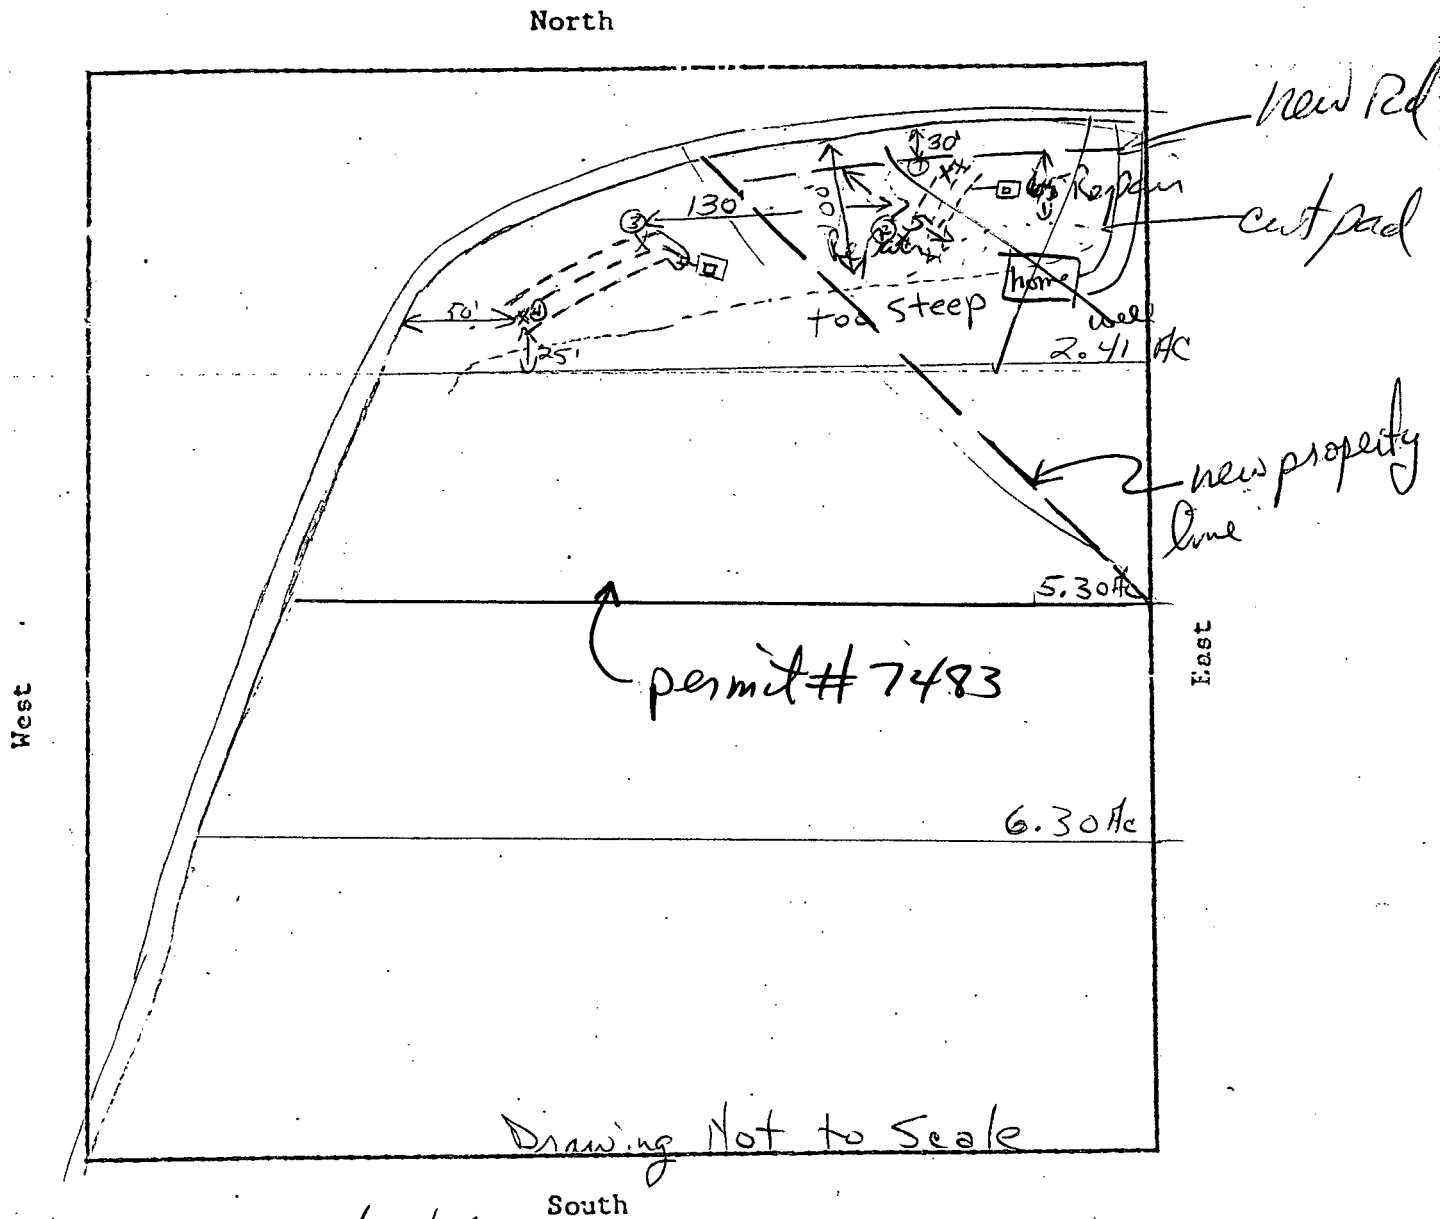

Two sites were evaluated
 Approval is specific only for area designated on plot
 plan. No structures, excavation or traffic is allowed
 but only one site is approved
 over this area and no wells within 100 ft. of this area.
 with this report. Sewer
 system can be located one of
 two places shown above
 #3 & 4
 1/10/77

CD Costanzo
 Health Department Representative

Date _____

PERMIT NO. _____

DO NOT WRITE IN THIS SPACE

ZCP II 1105

②✓

NUMBER: HD PRIVATE

SITE INVESTIGATION

Date 1-5-77

N^o 3950

Josephine County Health Dept.

Name of Property Owner Jack Baker Phone 862-2464

Mailing Address of Property Owner 1025 Board Shanty Ln Rd G.P.

Name of Developer Phone

Mailing Address of Developer

General Directions to Development, Including Landmarks Granite Hill Rd

plot on back of ZCP (2.96 ac. #2203 Now)

(attach copy of assessor's map) Township 35 Range 5 Section 29-2 Tax Lot Number 2203

Metes and Bounds, if Part of a Tax Lot 10/14/87 - per ASSESSOR'S OFFICE - Lot 4 CANCELLED

AS of MARCH '79 - 2.96 ACRES WENT TO

Total Acreage 6 ac Dimensions TL 220.3, - (BALANCE TO COUNTY ROAD)

Number of Building Sites Desired Number of Mobile Home Spaces Desired AS of APRIL '82

Source of Water Supply: Individual - Well (drilled driven dug) Surface Spring

Public: City Community System (name)

Plot plan required for final approval

\$ 2500 cash 1-5-77 Signature of Developer Jack D. Baker Clerk A.M. 2500

Fee Received

Signature of Developer

Clerk

FIELD INFORMATION REQUIRED

General Topography Site A 21%. Site B 23-25%

Relationship to Existing Domestic Water Sources

Hydrology: (1) Depth to ground water table (representative) above @ all test holes No H₂O @ restrictive layers

(2) General description of methods to be used for removal of ground or surface water (if applicable)

Relationship to Natural Water Courses (rivers, lakes, etc.)

Soil Limitations: (If percolation tests are requested, attach results to this form. The percolation test form will be provided by the Health Department)

Site A ① Gravel clay 0-24" restrictive clay 24" +
② same restrict @ 33" +
3 " " " 26" +

Site B ① Gravel clay 0-20" Restrict clay 20" +
② same, restrict @ 22"
③ " " " 30"

Confirmed 1/10/77 P. Peterson Soil Scientist

Miscellaneous Information

1/7/76 Date

DDC RS

Person Performing Investigation and Title

FOR USE BY HEALTH DEPARTMENT

We have found the above described property: Acceptable Conditionally Acceptable

Not Acceptable X for use with individual sewage disposal systems.

To obtain clearance on a conditionally approved property the following is necessary:

Our reason for denial of a septic tank system is as follows:

DDC

Sanitarian

1/10/76 77 Date



ENVIRONMENTAL HEALTH SERVICES

COUNTY HEALTH DEPARTMENT

JOSEPHINE COUNTY OREGON

Location: 101 ~~234~~ N.W. 'A' STREET

GRANTS PASS, OREGON 97526

Mailing Josephine County Court House

Address: Grants Pass, Oregon 97526

11 January 1977

Jack Baker
1025 Board Shanty Creek Road
Grants Pass, Oregon 97526

Re: Notice of Denial of a Septic Tank
Permit Number _____ or Site
Investigation Number 3950

Description: Granite Hill Road
T35-R5-Sec29-2 TL2202

Dear Sir,

On 1/10/77, Charles D. Costanzo, authorized agent of the Department of Environmental Quality, examined your building site for a proposed installation of a subsurface sewage disposal system. On the basis of that examination and inspection, the undersigned sanitarian has determined that approval cannot be given at this time to your request. The proposed installation would be in violation of the following administrative(s) rules and for the reason(s) given:

ReasonsApplicable Rule

- | | |
|---|---|
| 1. ☒ An impervious layer is less than 36 inches below the ground surface or less than 12 inches below the bottom of the effective sidewall. | 1. OAR Chap. 340, Div. 7, Subd. 1, Section 71-030 (1),(a) |
| 2. ☒ An impervious soil layer was found _____ inches from the ground surface having a surface slope of _____ percent. | 2. OAR Chap. 340, Div. 7, Subd. 1, Section 71-030 (1),(c),(e) |
| 3. ☒ A restrictive soil layer is less than 30 inches below the ground surface or less than 6 inches below the bottom of the effective sidewall. | 3. OAR Chap. 340, Div. 7, Subd. 1, Section 71-030 (1),(b) |
| 4. ☒ A restrictive soil layer was found <u>33</u> inches from the ground surface having a surface slope of <u>21</u> percent. | 4. OAR Chap. 340, Div. 7, Subd. 1, Section 71-030 (1),(e) |
| 5. ☒ Surface slope is in excess of 25 percent. | 5. OAR Chap. 340, Div. 7, Subd. 1, Section 71-030 (1),(e) |
| 6. ☒ Temporarily perched watertable will be in contact with the disposal field and is within 24 inches of the ground surface. | 6. OAR Chap. 340, Div. 7, Subd. 1, Section 71-030 (1),(d) |

Reasons (cont.)Applicable Rule (cont.)

7. ☒ Insufficient area available for a full subsurface sewage system replacement.
8. ☒ Does not meet the minimum set-back requirements as follows:
- _____
- _____
- _____
9. ☒ Permanently perched or regional watertable is within 4 feet of the bottom of the effective sidewall.
10. ☒ Other _____
- _____
- _____

7. OAR Chap. 340, Div. 7, Subd. 1, Section 71-020 (3),(a),(d)
8. OAR Chap. 340, Div. 7, Subd. 1, Section 71-020 (2)
9. OAR Chap. 340, Div 7, Subd. 1, Section 71-030 (1),(c)
- 10.

We have regretfully denied your application for a subsurface sewage disposal system. We want to inform you though that this denial is for the specific area we have observed and may not hold true for the total property. We encourage you to make contact with us for purposes of discussing possible alternate sites. You may be able to provide additional soil test holes in different areas of your property that will be acceptable.


If an alternate site on your property is not found one of the following options may offer a possible solution:

1. VARIANCE - \$150.00 fee is required and public hearing is held. May be allowed to vary from the standard rules legally.
2. ALTERNATIVE SYSTEM - (Holding tank, lagoon or land irrigation) Requires some engineering detail.
3. EXPERIMENTAL SYSTEMS - Requires a specific proposal to be submitted to the Department of Environmental Quality.
4. RURAL AREAS - Requires 10 acres or more in an area zoned for EF (exclusive farm), FR (forest resource), WR (wild rivers)

If there are any questions please call 476-8201 (Ext. 350) and we will do our best to answer them.

Sincerely yours,

C. WILLIAM OLSON, M.P.H., DIRECTOR,
Environmental Health Services and
Assistant Administrator

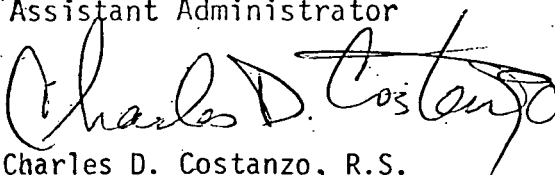
Charles D. Costanzo, R.S.

ZONING CLEARANCE PERMIT
Josephine County, Oregon

Date 27 Dec 76

Zoned Area V

Owner Baker, Jack

Mailing Address 1025 Board Shanty Cr Rd

Property Description

Subdivision-Name _____ Lot _____ Block _____
Twp 35 Range 5 Section 29-2 Tax Lot 2202
Size or Lot-Width 310 Depth 290 Total Area 6 Ac
Fronting on Granite Hill Rd

Proposed Use

Residential one only If mobile home, state size _____

Commercial _____ Industrial _____ Other _____

Does a residence presently exist on this parcel: Yes _____ No ☒

Subsurface Sewage Disposal System on this Parcel? Yes _____ No ☒

Provisions: _____

NOTE: PLEASE RETAIN THIS DOCUMENT & BRING IT WITH YOU WHEN APPLYING FOR SEPTIC, SEWER, ELECTRICAL & BUILDING PERMITS.

Jack Baker
Signature of Applicant

District Classification SR-5 Minimum Lot Size 5 Ac

Any structure to be placed on the above mentioned lot must observe the following setbacks:

30 From Front Property Line (Note: Corner lots have 2 front yards)
60 From Center Line of Road 20 From Rear Property Line
10 From Left Side Property Line 10 From Right Side Property Line

Approved by: Wray A. Marshall
No. 1105