


This map was prepared for
assessment purpose only.

JOSEPHINE COUNTY

1" = 400'

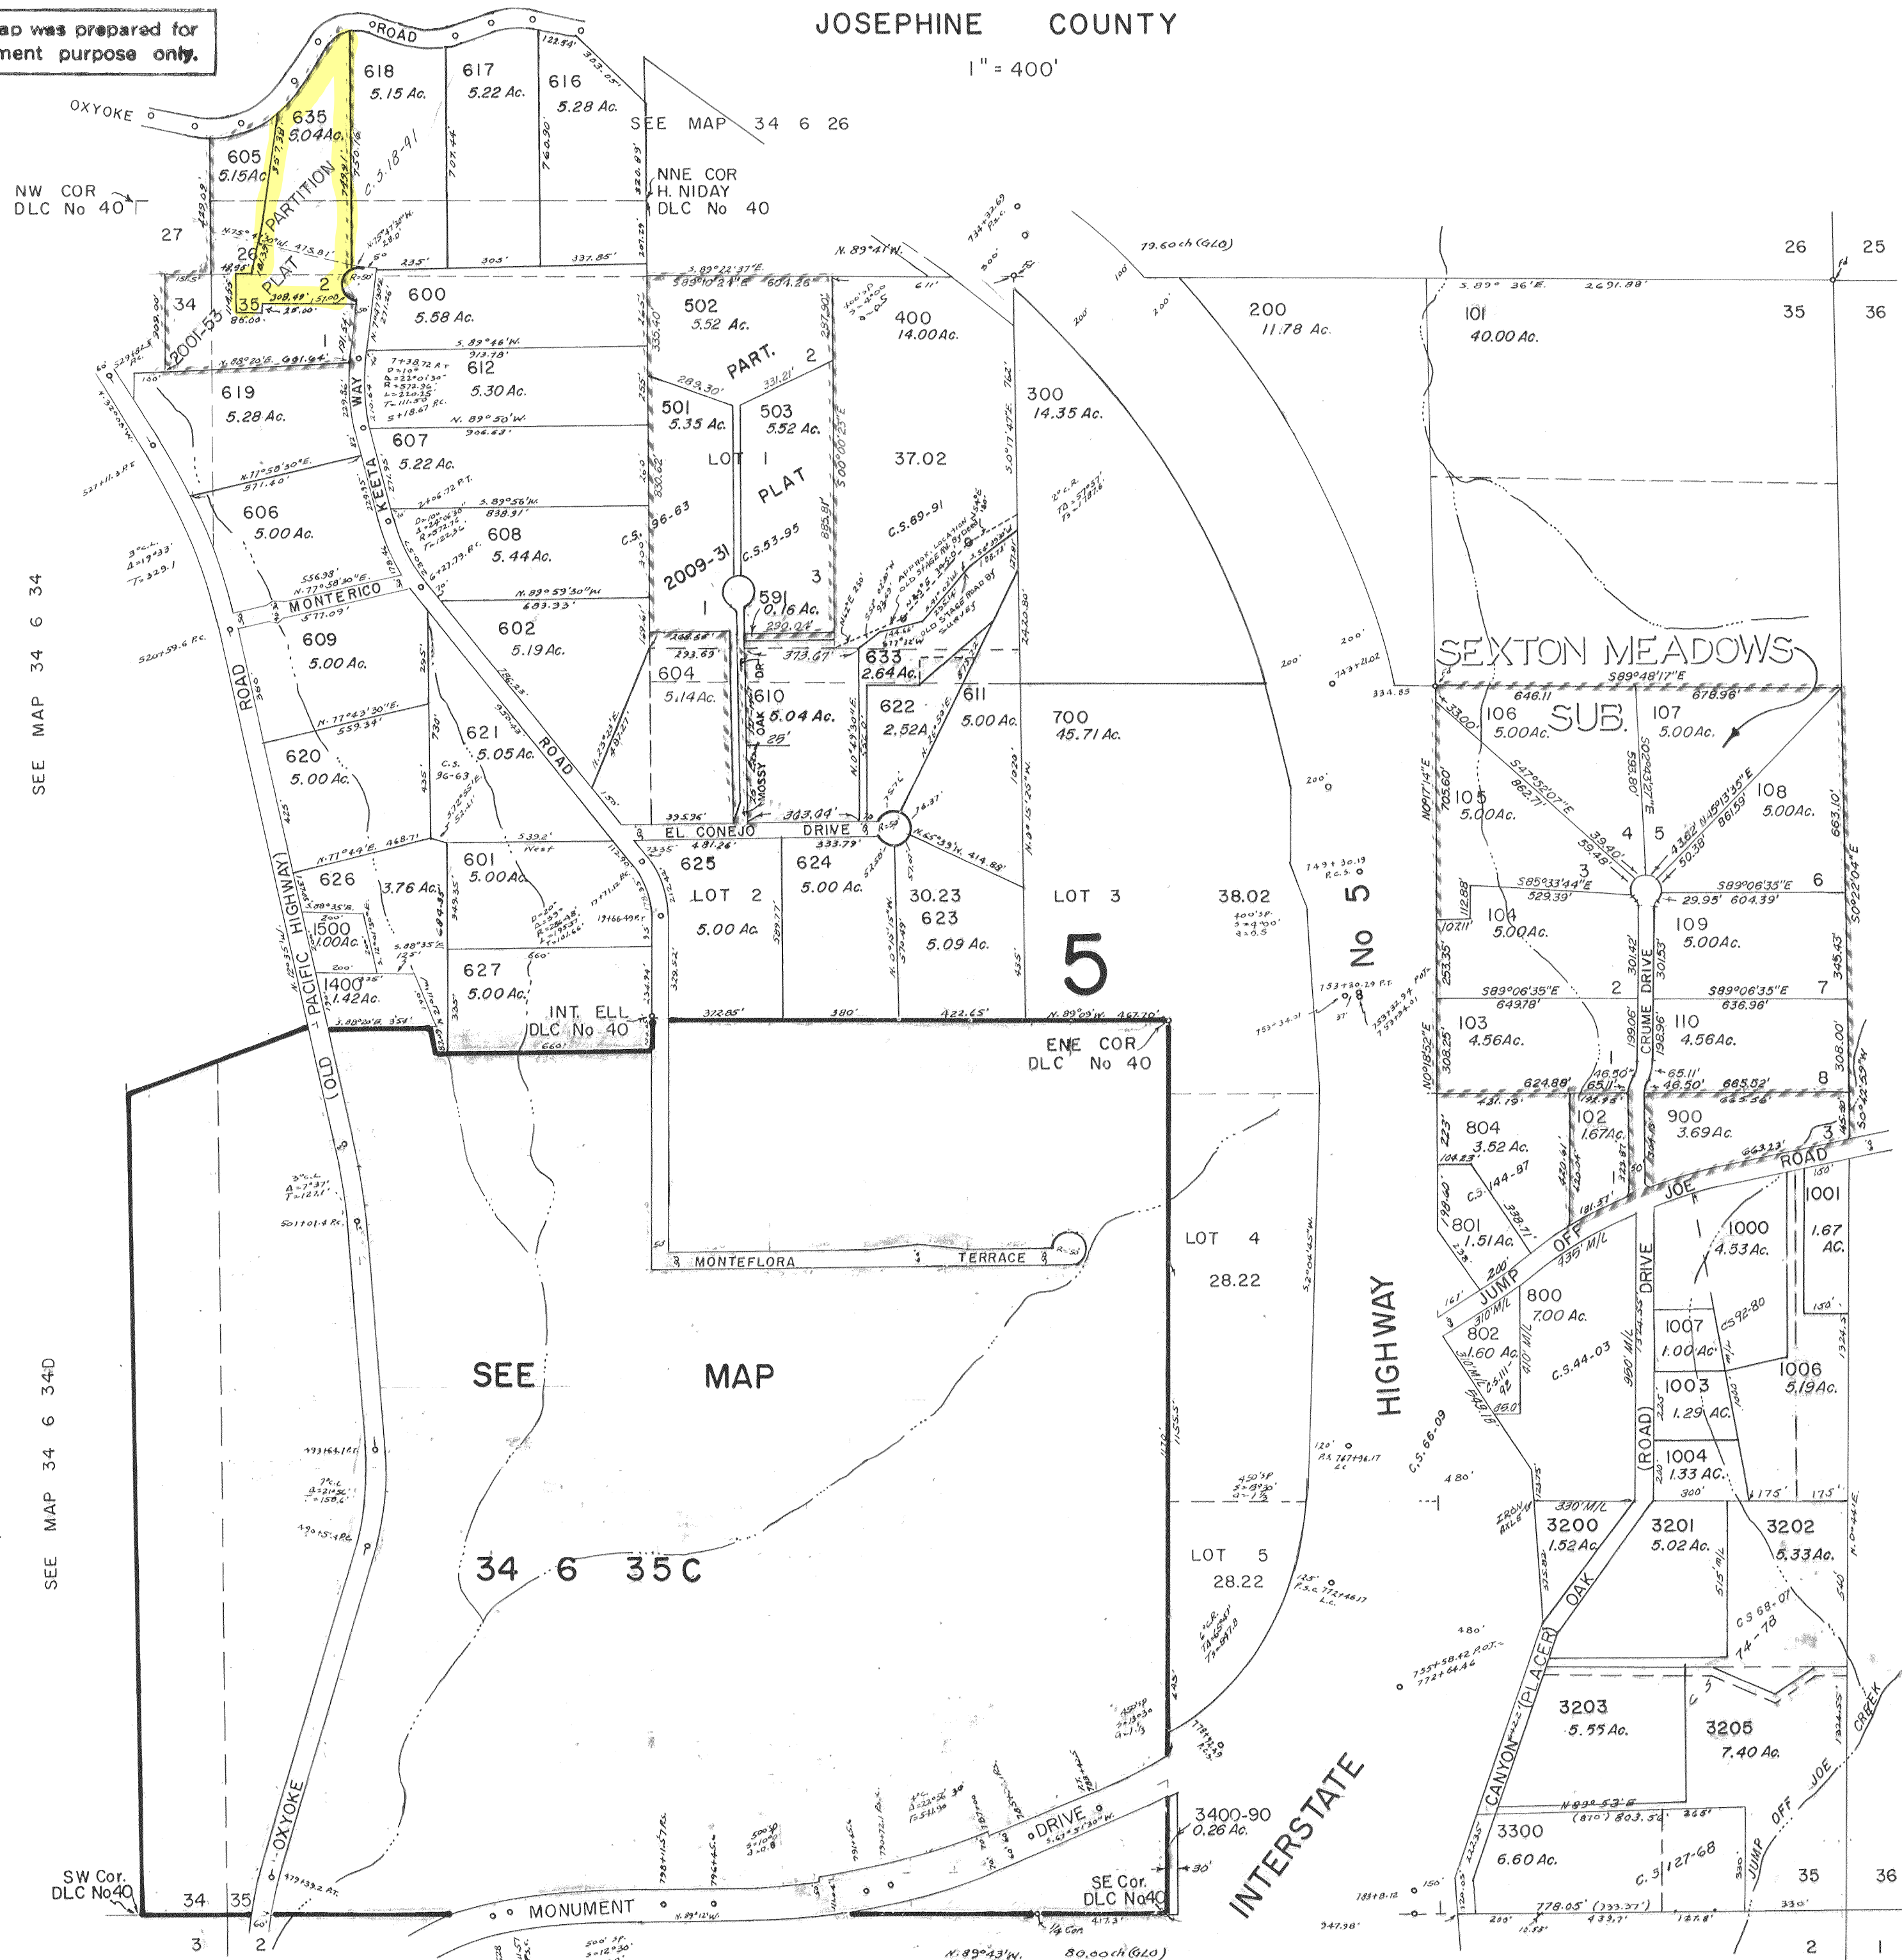

CANCELLED T. L.

2201	1200
2401	1201
613	1203
3301	1204
2202	1290
2490	1301
2390	1301-40
2391	1302
2392	1303
631	1304
590	1601
3001	1800
3002	1900
3290	2000
1103	2001
1190	2100
3291	2200
3204	2300
1202	2400
3292	2402
2200	2403
603	2404
614	2491
615	2500
628	2600
629	2700
630	2800
631	2900
632	3000
633	3001
1001	3002
1002	3003
1003	3004
1004	3100
1005	3190
592	1002
690	190
1005	1005
100	100
632	100
500	500

62507

Control No.

2/27/01

STATE OF OREGON

PERMIT NO. 1701-067

DEPARTMENT OF ENVIRONMENTAL QUALITY

Activity is specific only for area designated on plot plan. No structures, excavation or traffic is allowed over this area and no wells within 100 ft. of this area.

\$ 705.00

Fee

Foundation lines of any structure must be a minimum of 5 ft. from the septic tank & a minimum of 10 ft. from the disposal field. No vehicular traffic is allowed over the



New Construction



Repair



Other

Permit Issued To

SQUIRES, PHILIP E.

(Property Owner's Name)

34

(Township)

6

(Range)

35

(Section)

TL 605

(Tax Lot / Acct. No.)

Josephine

(County)

1395 Oxyoke Rd.

(Road Location)

Grants Pass

(City)

Richard E. Blake

(Issued by - Signature)

7-12-01

(Date Issued)

PERMITS ARE NOT TRANSFERABLE

ALL WORK TO CONFORM TO OREGON ADMINISTRATIVE RULES, CHAPTER 340. WORK SHALL BE DONE BY PROPERTY OWNER OR BY LICENSED SEWAGE DISPOSAL SERVICE. (MAKE NO CHANGES IN LOCATION OR SPECIFICATIONS WITHOUT WRITTEN APPROVAL)

SPECIFICATIONS

EXPIRATION DATE 7-12-02

TYPE OF SYSTEM STANDARD

* EXISTING

Design Sewage Flow 450 Gallons/Day

Tank Volume 1000 Gallons

Disposal Trenches ☒Seepage Bed(s) ☐

750 Square Feet

Maximum Depth 27 inches.

Minimum Depth 24 inches.

375 Linear Feet

Equal ☐Loop ☐Serial ☒Pressurized ☐

Minimum Distance Between Trenches

10' ON CENTER

Total Rock Depth 12 inches.

Below Pipe 6 inches.

Above Pipe 2 inches.

☐ Rake Sidewall

Special Conditions (Follow Attached Plot Plan) 50' SET-BACK TO SEASONAL CREEK.

THIS PERMIT FOR INSTALLATION OF EFFLUENT SEWER & DRAINFIELD

PRE-COVER INSPECTION REQUIRED — CONTACT 471-2880

S.E. # 0017-187

CERTIFICATE OF SATISFACTORY COMPLETION

As-Built Drawing
with Reference Locations

Installer ED OWNBEY

Final Insp. Date 9-7-01

☒ Inspected By R. Blake☐ Issued by Operation of Law

☐ Pre-cover inspection waived
pursuant to OAR 340,
Division 71

* TANK INSTALLED UNDER PERMIT # 10016
FOR HARDSHIP MOBILE.

PARCEL BEING SPLIT & HARDSHIP
MOBILE CONVERTED TO PERMANENT DWELLING.

ATTENTION: OREGON LAW REQUIRES YOU TO FOLLOW RULES
ADOPTED BY THE OREGON UTILITY NOTIFICATION CENTER.
THOSE RULES ARE SET FORTH IN OAR 952-001-0010 THROUGH
OAR 952-001-0090. YOU MAY OBTAIN COPIES OF THE RULES
BY CALLING THE CENTER. (NOTE: THE TELEPHONE NUMBER
FOR THE OREGON UTILITY NOTIFICATION CENTER IS
(503) 232-1987 or 1-800-332-2344).

In accordance with Oregon Revised Statute 454.665, this Certificate is issued as evidence of satisfactory completion of an on-site sewage disposal system at the location identified above.

Issuance of this Certificate does not constitute a warranty or guarantee that this on-site disposal system will function indefinitely without failure.

Richard E. Blake
(Authorized Signature)

On-Site Spec. / RS
(Title)

9-7-01
(Date)

WR-GP
(Office)

GRANTS PASS OFFICE
DEPARTMENT OF ENVIRONMENTAL QUALITY

RECORD OF SEWAGE DISPOSAL SYSTEM


Property Owner: Squires Philip E. Permit # 1701-067
Installation Address: 1395 Oxyone Rd.
Twp. 34 R 6 Sec. 35 TL 605

Septic Tank Information: Liquid Capacity 1000 Material Existing Concrete
Manufacturer Riverside
Distance from well: _____

Drainfield Information: Total Linear Ft. 375' Depth of Rock Under Pipe 6"
Total Rock Depth 12"
Distance from well: _____

As-Built Sketch - Show all wells, roads, structures, and landscape features.

****IDENTIFY THE SEPTIC TANK LID IN RELATION TO SOME FIXED FEATURE OR STRUCTURE****

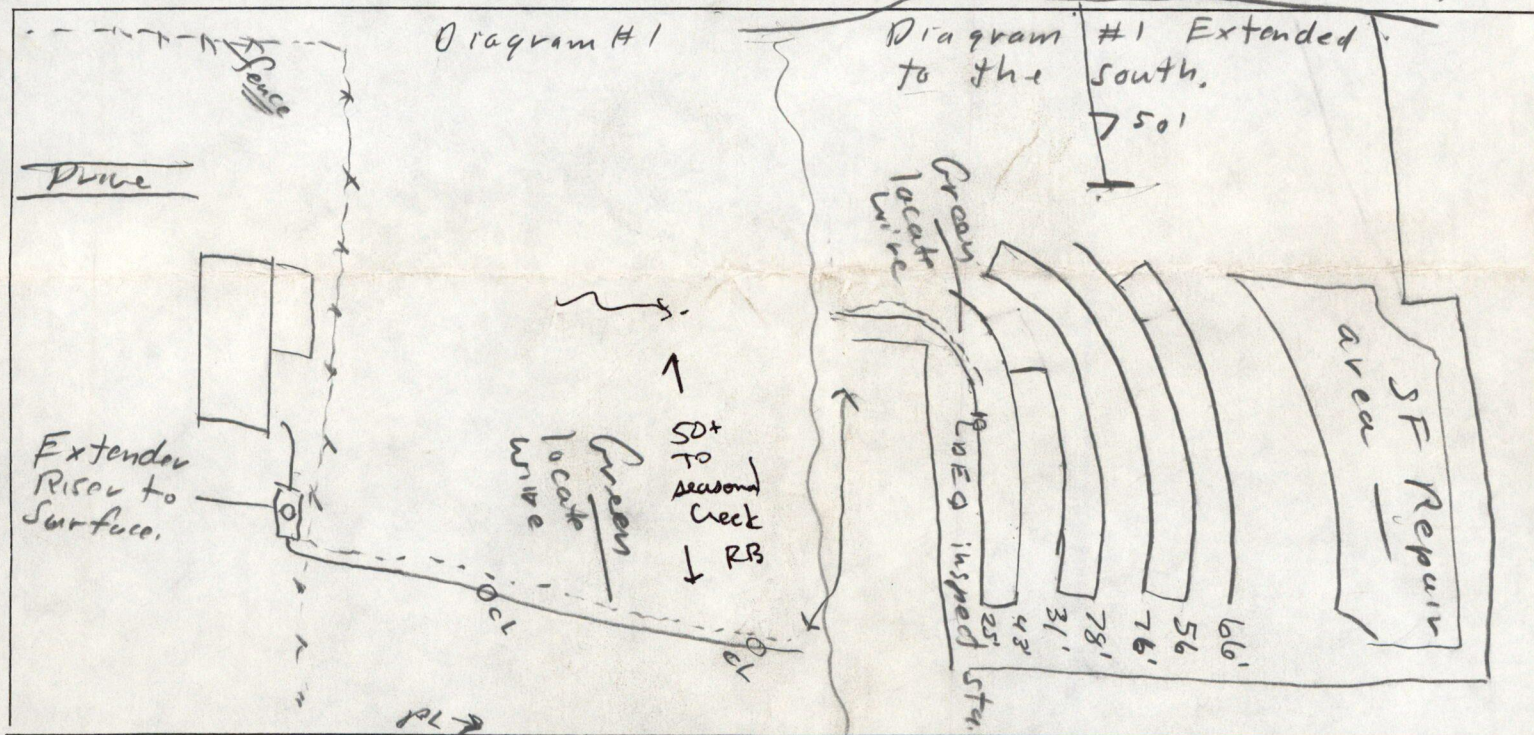

I certify that the construction of this on-site sewage disposal system complies with the Oregon Administrative Rules for On-Site Sewage Disposal, Chapter 340, Division 71, 72, and 73.

Installer's Name: Ed Oumboy Date: 9-6-01

DEQ License #: 35021

For Office Use Only: Date of Final Inspection: 9-7-01

Remarks: _____

INSTALLATION APPROVED - OK TO COVER

TANK PUMPED 2-7-01

R Blake

D & D Sani.

Date Received 9-7-01 RB

FINAL INSPECTION REQUEST AND NOTICE

Pursuant to the requirement within ORS 454.665, OAR 340-71-170, and OAR 340-71-175 the system installer and/or the permittee must notify the Department of Environmental Quality (or its authorized Agent) when the construction, alteration, or repair of a system for which a permit was issued is completed (except for the backfilling or covering of the installation). The Department (or Agent) has 7 days to perform an inspection of the completed construction after the official notice date, unless the Department (or Agent) elects to waive the inspection and authorized the system to be backfilled earlier. Receipt and acceptance of this completed form by the Department (or Agent) establishes the official notice date of your request for the pre-cover inspection. Please complete all sections of the form and return it to the office that issued the permit. Forms that are determined to be incomplete will be returned.

SECTION 1: BASIC INFORMATION.

Property Owner P SQUIPPES Permit Number 1701-067 County Deschutes

Township 24 ; Range 6 ; Section 25 ; Tax Lot 605 Tax Acct.# _____

Job Location 1375 CROOK RD Grant, OR

Date System Construction Completed Sept 5 2001 ; Date submitted to DEQ or Agent Sept 6 2001

SECTION 2: MATERIALS LIST. Identify and list all materials used in the system's construction.

MATERIAL	SIZE	SPECIFICATION	AMOUNT
Pump <u>Chase Dunn</u>	<u>4"</u>	<u>2729 Solid</u>	<u>52'</u>
Distribution Pipe	<u>4"</u>	<u>2729</u>	<u>375'</u>
Effluent Sewer Pipe	<u>4"</u>	<u>3034 with 2 40 between Mobil & D/F</u>	<u>505'</u>
Drain Media	<u>1 1/2 inch black shale</u>		<u>40 yds</u>
Filter Material		<u>straw</u>	<u>4 bales</u>
Other <u>1094 4" 90° 45° Tee's</u>			

Sand Filter Materials: (attach sand certificate and sieve analysis)

Container _____

Under Drain _____

Under Drain Media _____

Filter Fabric _____

Manifold Pipe _____

Fittings _____

Pump _____

Other _____

SECTION 3: WATER TIGHT TANK TEST. Fill tank to a point at least 2" into riser.

TANK	DATE	WATER LEVEL	COMMENTS
Filled	<u>Sept 3 2001</u>	<u>Flow line of tank</u>	
Checked	<u>Sept 5 2001</u>	<u>Flow line of tank</u>	
Recheck			

Test results are true and accurate:


[Signature]
Signature of person performing test

3034 Drain line from tank to
 #1 leach line drawn in 67
 Ed Gwiboy 6-28-01
 map to scale -
TENTATIVE PLAN
PROPOSED LAND PARTITION
RE: APPLICATION FOR SEPTIC PERMIT # 1701-067
1395 OXYOKE ROAD
T34S, R6W, SEC 35, TL # 605
 new plot plan as of
 6-26-01 -

Approval is specific only for area designated on plot plan. No structures, excavation or traffic is allowed over this area and no wells within 100 ft. of this area.

SCALE: 1" = 100'

Foundation lines of any structure must be a minimum of 5 ft. from the septic tank & a minimum of 10 ft. from the disposal field. No vehicular traffic is allowed over the tank or field.

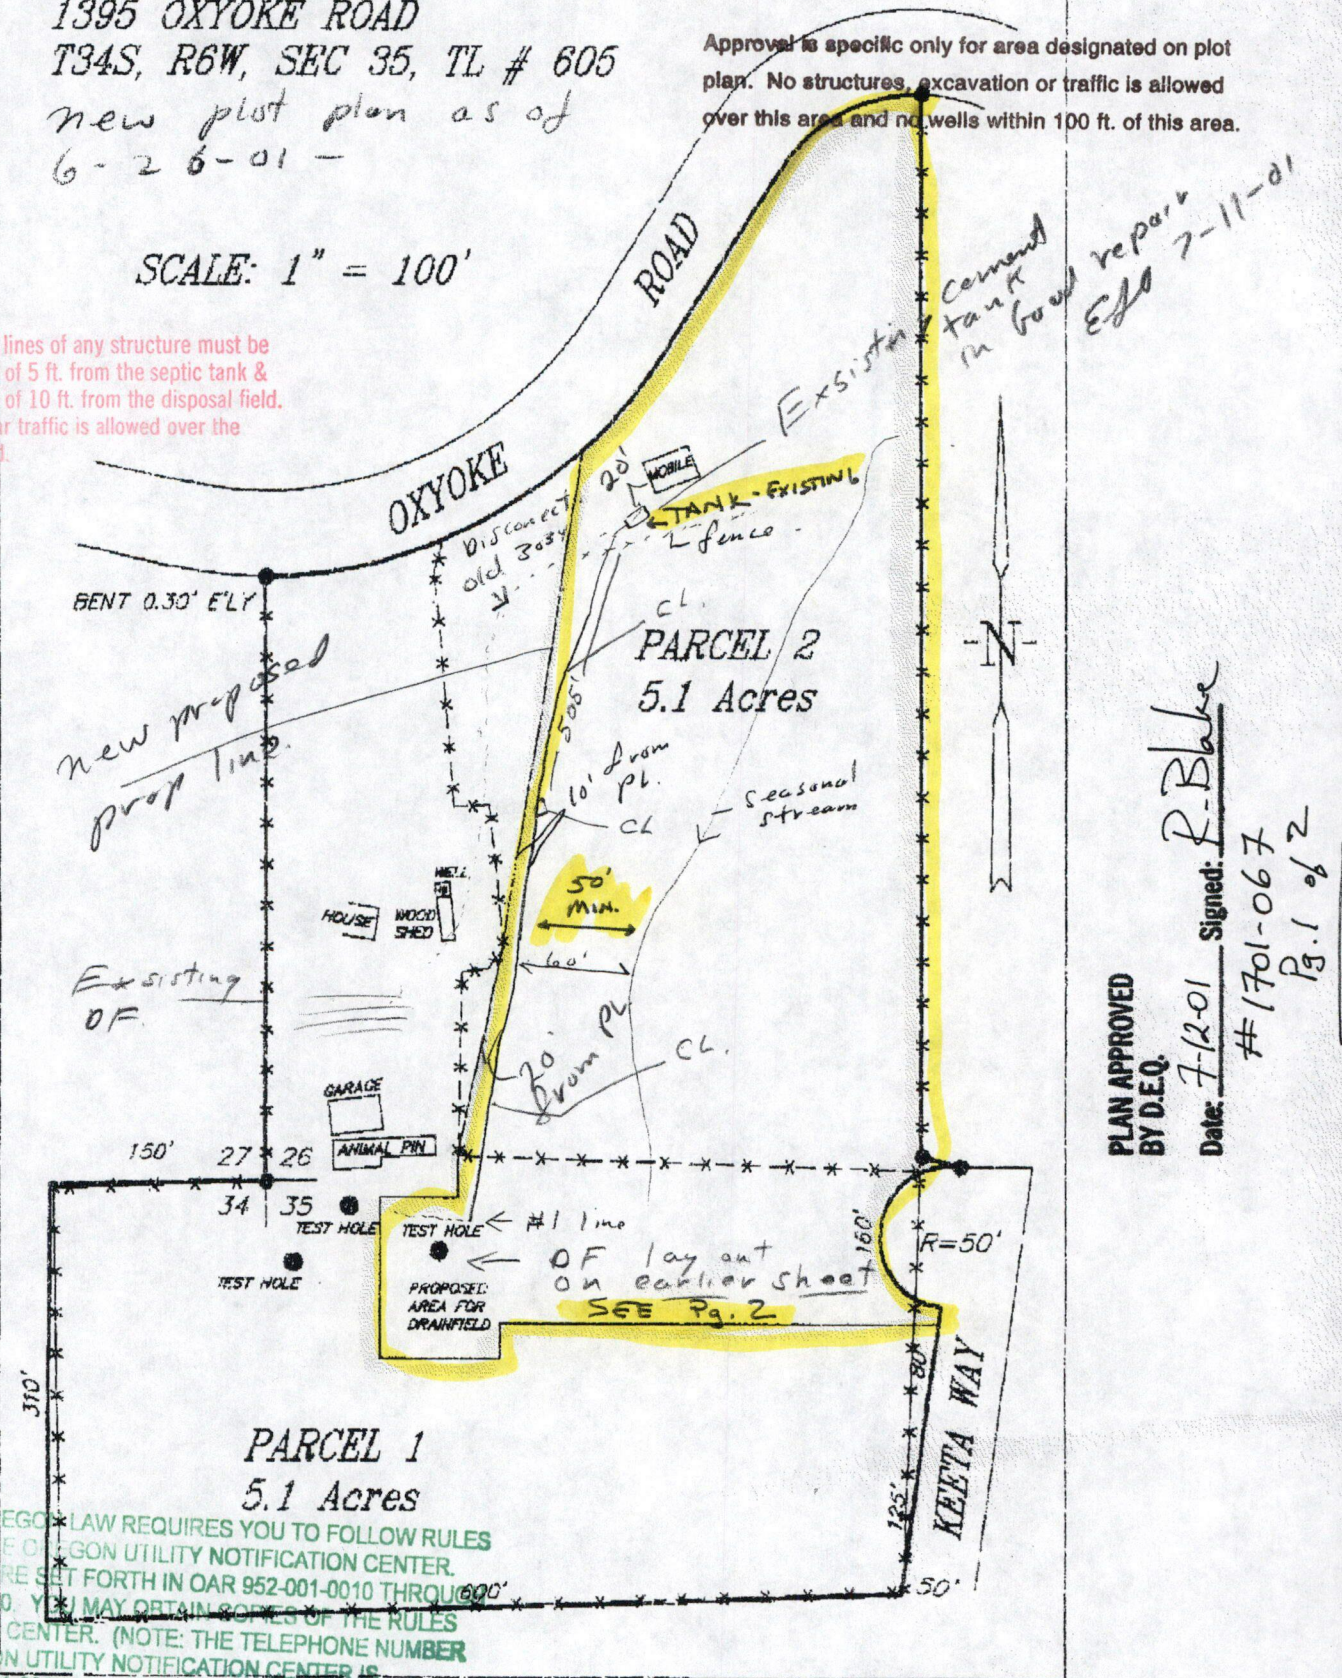

PLAN APPROVED
 BY D.E.Q.

Date: 7-12-01 Signed: R. Blake
 #1701-067
 Pg. 1 of 2


ATTENTION: OREGON LAW REQUIRES YOU TO FOLLOW RULES ADOPTED BY THE OREGON UTILITY NOTIFICATION CENTER. THESE RULES ARE SET FORTH IN OAR 952-001-0010 THROUGH 952-001-0050. YOU MAY OBTAIN COPIES OF THE RULES BY CALLING THE CENTER. (NOTE: THE TELEPHONE NUMBER FOR THE OREGON UTILITY NOTIFICATION CENTER IS (503) 232-1987 or 1-800-332-2344).

34-G-35 of 1395 Qxydke Rd.
 34-G-26- TL605
 Tax Reference: 34-G-26- TL605 Evaluator: Chuck C.

Applicant: Phil Sguyres Date: 1-30-01

map not to scale map by Ed Dumber

(SE# 0017-197)

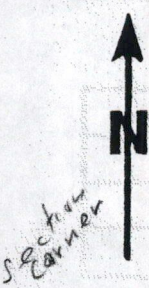

Foundation lines of any structure must be a minimum of 5 ft. from the septic tank & a minimum of 10 ft. from the disposal field. No vehicular traffic is allowed over the tank or field.


REVISED PROP. LINE.

EFFLUENT SEWER FROM SEPTIC TANK SEE Pg. 1

wh stake RB

approval is specific only for area designated on plot plan. No structures, excavation or traffic is allowed over this area and no wells within 100 ft. of this area.

1-7 = 354'
 8-10 176
 530

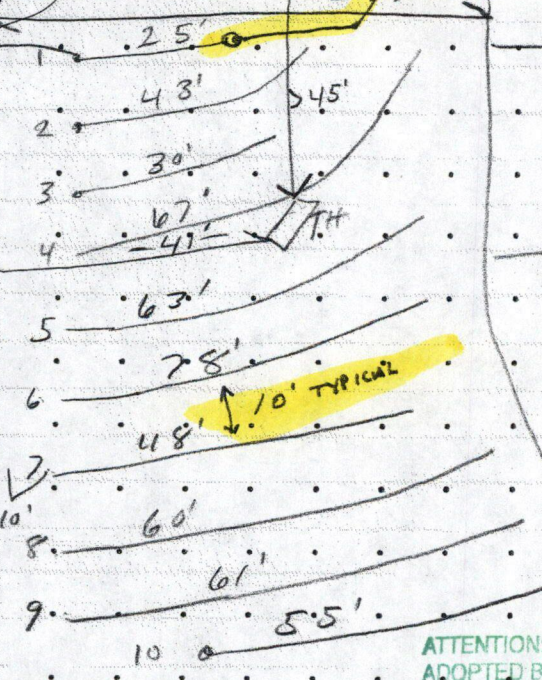

Seasonal Creek

ATTENTION: OREGON LAW REQUIRES YOU TO FOLLOW RULES ADOPTED BY THE OREGON UTILITY NOTIFICATION CENTER. THOSE RULES ARE SET FORTH IN OAR 952-001-0010 THROUGH OAR 952-001-0095. YOU MAY OBTAIN COPIES OF THE RULES BY CALLING THE CENTER. (NOTE: THE TELEPHONE NUMBER FOR THE OREGON UTILITY NOTIFICATION CENTER IS (903) 232-1987 or 1-800-332-2344).

wh. STAKE RB

Line

375' started out STD Int
 150' started out SF Repair
 started out 1-30-01

Ed Dumber

1000gal tank already installed

OK check revision list split map.

PLAN APPROVED BY D.E.Q.

Date: 7-12-01 Signed: R Blake

1701-067
 Pg. 2 of 2



Oregon

John A. Kitzhaber, M.D., Governor

Department of Environmental Quality

Western Region

Grants Pass Branch Office

510 NW 4th St., Rm #76


Grants Pass, OR 97526-2019

(541) 471-2850

Memorandum

To: Lora Glover
Josephine County Planning Dept.
510 NW 4th Street
Grants Pass, OR 97526

Date: 6/25/01

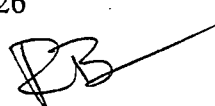From: Richard Blake 

RE: Rebecca A. & Philip E. Squyres
1395 Oxyoke Road
T.34 R.6 Sec.35 TL# 605
Proposed Partition

This Department has approved an area for the installation of a drainfield, Site Evaluation #0017-187, to serve the mobile home being converted from a hardship to a residence.

A New Construction permit, #1701-067, was applied for on 2/27/01. To date, this permit has **not** been issued. An acceptable plot plan showing the effluent sewer (pipeline from the septic tank to the drainfield) meeting required setbacks to property lines and the seasonal creek has **not** been submitted. The proposed lot line may not allow for the setbacks to be met.

It appears the lot lines may have to be altered, or under Oregon Administrative Rules (OAR) 340-071-0130-(11), a utility easement to cross the property line to maintain the setback to the seasonal creek could be obtained.

The hardship mobile home connection had been previously approved in 1978 under permit #10016. The required hardship connection renewal inspections had not been applied for since at least 1993. The hardship setup was out of compliance with this Department.

The septic system for the original residence was issued in 1965, permit #494-S. The system was repaired in 1978, permit #8627.

If you have any further questions regarding this matter, please contact me at 541-471-2850 extension 23.



Oregon

John A. Kitzhaber, M.D., Governor

Department of Environmental Quality

Western Region

Grants Pass Branch Office

510 NW 4th St., Rm #76

Grants Pass, OR 97526-2019

(541) 471-2850

March 26, 2001

Rebecca & Philip Squyres
1395 Oxyoke Road
Grants Pass, OR 97526

RE: APPLICATION FOR SEPTIC PERMIT # 1701-067

1395 Oxyoke Road

T.34 R.6 SEC.35 TL# 605

Dear Mr. & Mrs. Squyres:

We are unable to approve your application for the above referenced septic permit at this time due to the following:

- The plot plan submitted by your contractor lacks sufficient detail for approval. It only shows the initial and replacement drainfield locations. (The stake out of the drainfield indicates there is adequate area for a standard initial drainfield and a sand filter replacement drainfield.) Please provide the following additional information:
 1. Show the entire construction plan for the lot, including the existing dwelling, septic tank, effluent sewer line, drainfield, drainage ways, and wells.
 2. Include distances from the septic system components to property lines, wells drainage ways and other items requiring setbacks.
- Development Permit #014-196 from the Josephine County Planning Department, that you have submitted, is for the existing 10.15 acre parcel. I understand that the parcel is to be divided. The final plat must be completed and a revised or new development permit obtained for this specific application.

If you have any questions regarding this matter, please call me at 541-471-2850 extension 23.

Sincerely,

Richard E. Blake


Richard E. Blake, RS

On-Site Wastewater Specialist

C: Ed Ownbey
Planning Dept.

*as per
Lora Glover
4-21-01
RB
Septic only!*



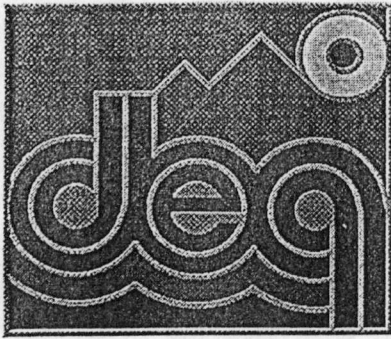

DEPARTMENT OF
ENVIRONMENTAL QUALITY
510 NW 4TH STREET ROOM: 76
GRANTS PASS, OR. 97527
(541) 471-2850

FOR OFFICE USE ONLY	
Date Received:	<u>2-27-01</u>
Date Completed:	<u>2-27-01</u>
Required Fee:	<u>\$105.00</u>
Receipt No.:	<u>97618</u>
Control No.:	<u>1701-067</u>

APPLICATION FOR:

- | | |
|--|---|
| ☐ SITE EVALUATION | ☒ NEW CONSTRUCTION PERMIT |
| ☐ REPAIR PERMIT | ☐ AUTHORIZATION NOTICE |
| ☐ ALTERATION PERMIT | ☐ HARDSHIP AUTHORIZATION |
| ☐ OTHER- PLEASE SPECIFY | |

REQUIREMENTS:

Plot Plan	☐ YES	☐ NO	INCLUDED:	☒ YES	☐ NO
Vicinity and Tax Lot Map	☐ YES	☐ NO		☒ YES	☐ NO
Test Pits- 5 feet deep	☐ YES	☐ NO		☒ YES	☐ NO
Development Permit	☐ YES	☐ NO		☒ YES	☐ NO

☐ There is a flag or sign at entrance to property and leading to test holes.

For Applicant- PLEASE PRINT

Philip E. Squyres 1395 Oxyoke Rd GP 97526
Property Owner's name Property Address
34 6 350726 605 Josephine
Township Range Section Tax Lot # County

Subdivision Name _____ Lot # _____ Block # _____ Acreage _____

Public Water Supply _____ Private Water Supply (Specify Type) _____
mobile 2
Single Family Residence- Number of Bedrooms Other- Specify

Directions to Property: _____

By my signature, I certify that the information I have furnished is correct and hereby grant the Department of Environmental Quality and its authorized agent permission to enter into the above described property for the purpose of this application.

Edward Ownbey 2/26/01
Signature Date
☐ Owner
☐ Authorized Representative
☒ D. S. License No. 13161

Owner's Mailing Address
Philip E Squyres
1395 Oxyoke Rd
GP, Ore 97526
Phone: 476-5900

Applicant's Mailing Address (if different)
Ed Ownbey
4600 Jerome Pt. Rd
GP Ore 97527
Phone: 476-2821

JOSEPHINE COUNTY DEVELOPMENT PERMITFEE: \$25 CHECK: 6213 CASH: _____PREVIOUS PERMIT # 92-253

TWN: 34 RNG: 06 SEC: 35 QQ: 00 TAXLOT: 000605

Permit No: 01-196

Situs: 1395 OXYOKE RD

ZONE: RR5

Applicant: SQUYRES, REBECCA A & PHILIP E

Applicant Phone: _____

Applicant Address: 1395 OXYOKE RD

GRANTS PASS, OR 97526-9780

Owner: SQUYRES, REBECCA A & PHILIP E

Owner Address: 1395 OXYOKE RD

GRANTS PASS, OR 97526-9780

YES NO

SPECIAL REQUIREMENTS

- ☐ ☒ Fire Safety Plan.
- ☐ ☒ Identified Wetland. 30 Day Notice to Oregon Division of State Lands Required (____).
- ☐ ☒ Water Hazard: ☐ Not Applicable
- ☐ Flood Plain Hazard. Required Homesite Elevation is one foot above _____ feet.
- ☐ Floodway Hazard. Approved Engineer's "NO-Rise" Study is in File (____).
- ☐ Non-Surveyed Flood Hazard (Zone A). Professional Certificate in File (____).
- ☐ ☒ Scenic Waterway Restriction. BLM Authorization in File (____).
- Overlay Restrictions: 50' Firebreak (☐) 1500' Aggregate Setback(☐) Erosion Control Plan (☐)
- Stream Setback: 50' from Class I Stream Bank (☐) 25' From Class II Stream Bank(☐)

EXISTING STRUCTURES

AWNING
DECKS
Mobile Home
ROOF CVR
CONCRETE
DECKS
FENCE (FIELD)
GARAGE
RESIDENTIAL
SHED
SHED CL 4
SHEDS & PENS

PROPOSAL

New Septic System

SETBACK REQ.

Front Setback: 30
Side Setback: 10
Rear Setback: 25
St. Centerline: _____
Acreage: 10.15
Violations: True

Additional Terms: _____

ACCESS: Maint County Rd* ☒State Highway* ☐Other / NA ☐

*Access permit required from County Public Works Dept or State Highway Division

OTHER PERMITS REQUIRED: ALL STRUCTURES APPROVED BY THIS PERMIT MUST ALSO BE AUTHORIZED BY SEPARATE PERMITS FROM THE DEPARTMENTS OF BUILDING & SAFETY AND ENVIRONMENTAL QUALITY.

FAILURE TO COMPLY WITH THE TERMS OF THIS PERMIT WILL RESULT IN REVOCATION. FALSIFICATION OF INFORMATION IS A VIOLATION OF STATE LAW.

Signature: Ed OumbyDate: 2/27/01Contractor Name: Mr Ed's BackhoeLicense #: 13161Approved: SkellenbeckDate: 02/27/01NOTE: AUTHORIZED USES MUST BE UNDERWAY WITH ALL REQUIRED PERMITS WITHIN 1 YEAR FROM DATE OF ISSUANCE. THIS PERMIT EXPIRES ON: 02/27/02

34 6 35